# Como and Minneapolis Road.

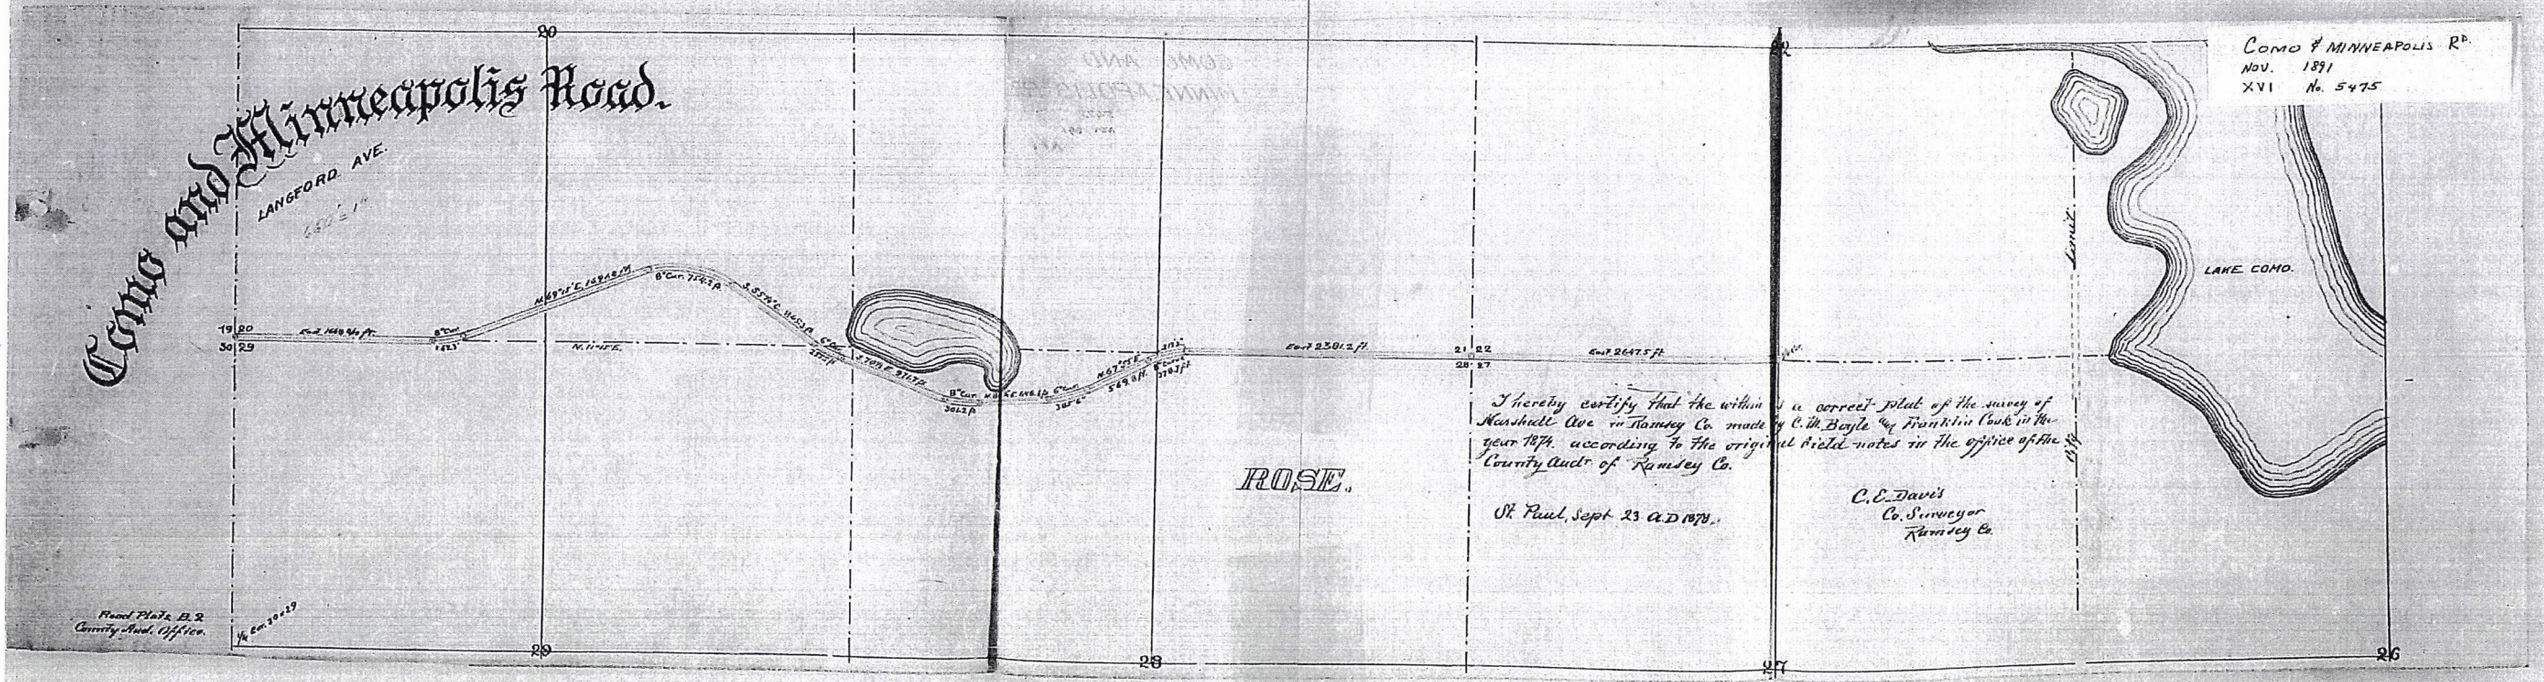


I hereby certify that the within is a correct plat of the survey of Marshall Ave in Ramsey Co. made by C. M. Boyle & Franklin Cook in the year 1874. according to the original field notes in the office of the County Auditor of Ramsey Co.

St. Paul, Sept. 23 A.D. 1878.

C. E. Davis
Co. Surveyor
Ramsey Co.