I certify that this is a correct diagram of the E½ of the NW¼ of Sec 2 Town 28 N° Range 22 W. as surveyed by me in the month of October A.D. 1898

David L Curtis C.E.

St Paul Minn Nov 1st 1898

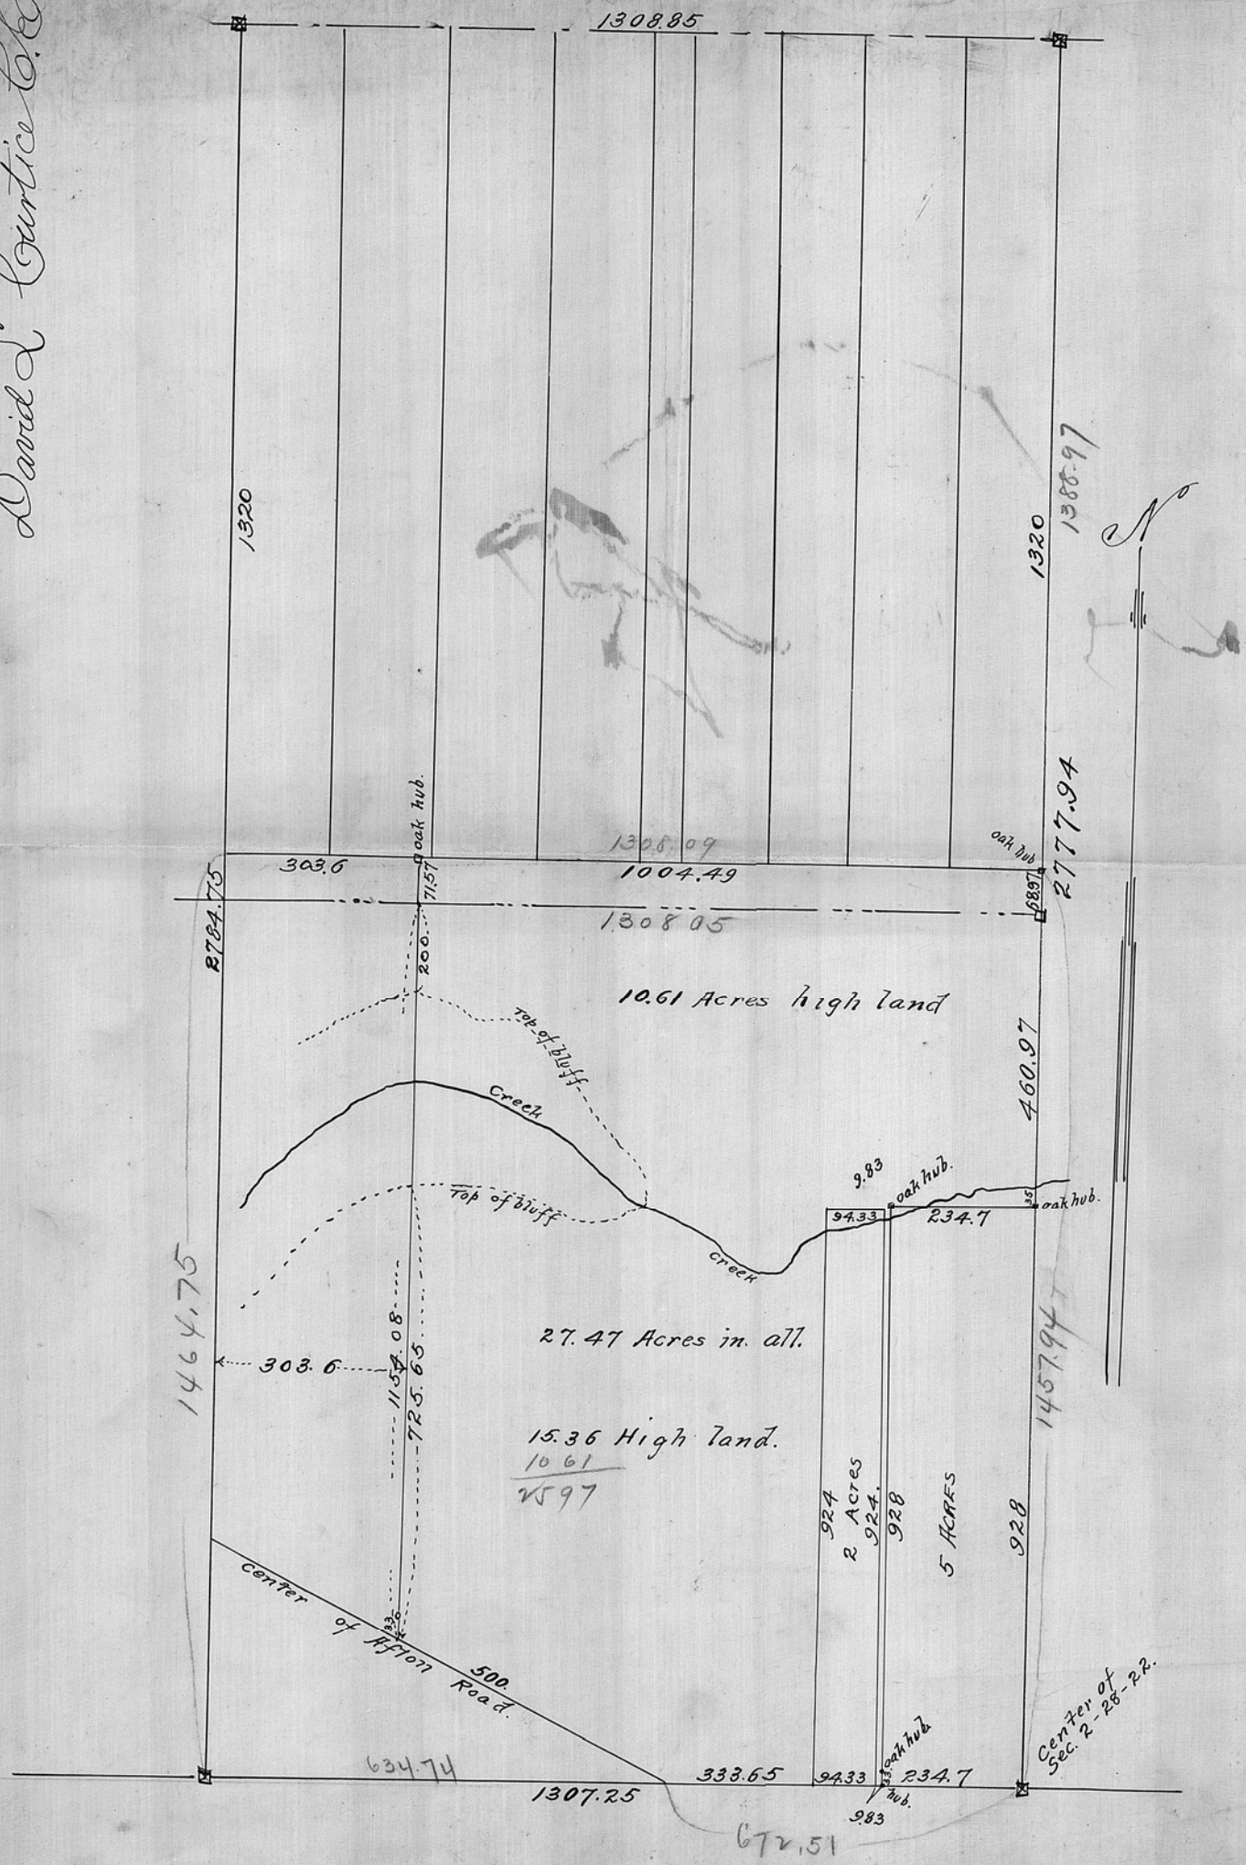

May 15/07