


PROPOSED FRONT No 170. W 3rd St.  
Elevation  
Scale 1/8 inch per ft.



PRESENT FRONT No 170 W 3rd St.  
Elevation.  
Scale 1/8 inch per foot.

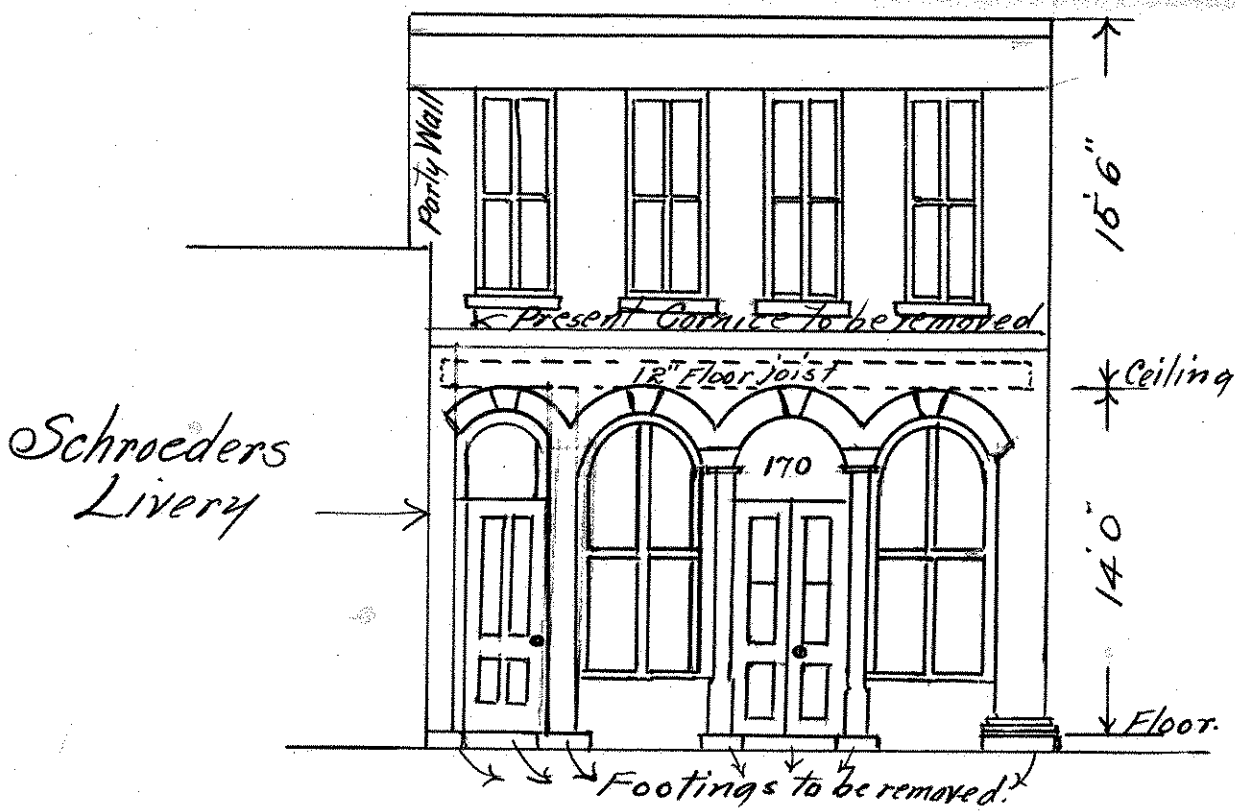