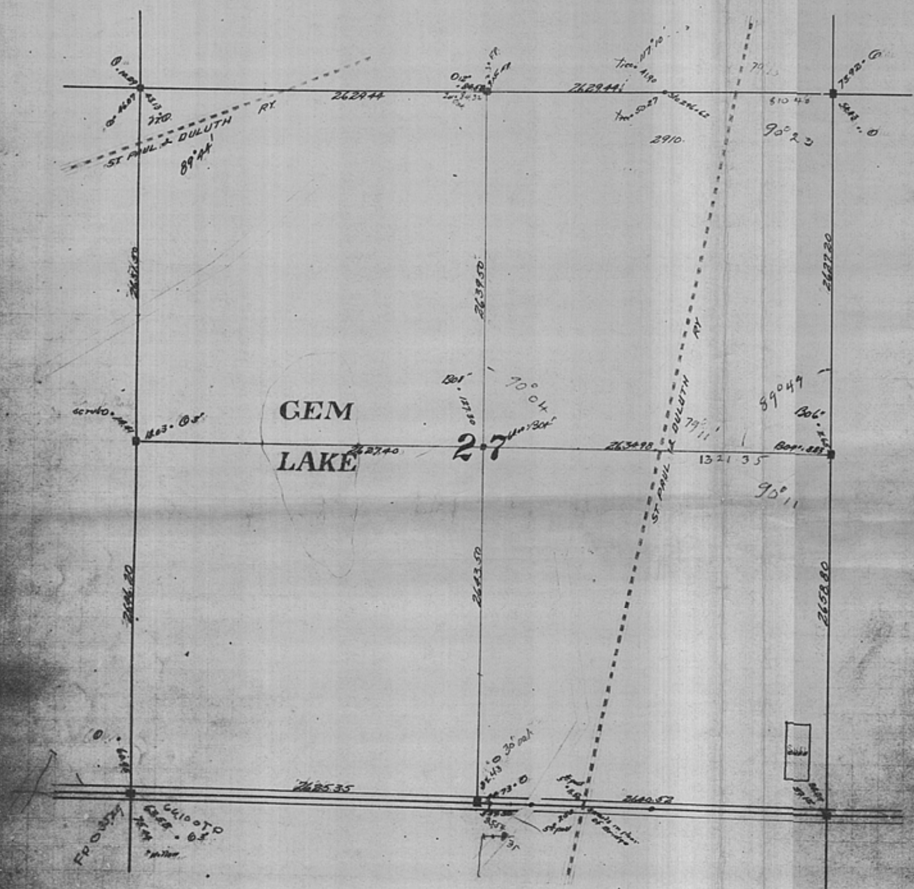

In Establishing the N.W. Corner Section 27 Ran East on straight line from 1/4 Corner between Sections 21 and 28 Government distance found remains of old Gov. stump Feb. 1900
Set Mont. July 1900

In Establishing the 1/4 Corner between Sections 22 and 27 Ran East from Section Corner Government distance Government witness trees gone Feb. 1900
Set Mont. March 1900

In Establishing the N.E. Corner of Section 27 Ran East from 1/4 Corner Government distance Government witness trees gone Feb. 1900
Set Mont. March 1900

In Establishing the 1/4 Corner between Sections 26 and 27 Ran straight line North and South and fixed 1/4 Corner and set Monument 1898
No Government trees.

Found old Boulder Monument 33 ft West of South East Corner of Section 27 fixed Section Corner and set Monument Government witness trees gone Found old stake at Corner
Aug. 1896.

In Establishing the 1/4 Corner between Sections 27 and 34 Measured West from South East Corner of Section 27 - 2640.52 which checked the line of fence running North Government witness trees gone Fixed [illegible] and set Monument. Aug. 1896

In Establishing the 1/4 Corner between Sections 27 and 28 Found old stake Government witness trees gone. Set Monument Aug. 16 - 1898

In Establishing the South West Corner of Section 27 Found Government witness stump and one old stake at Sec. Corner
Set Monument Aug. 16 - 1898

Fixed the Centre of Sec. 27 by Intersection and set Mont. Nov. 30 - 1900.