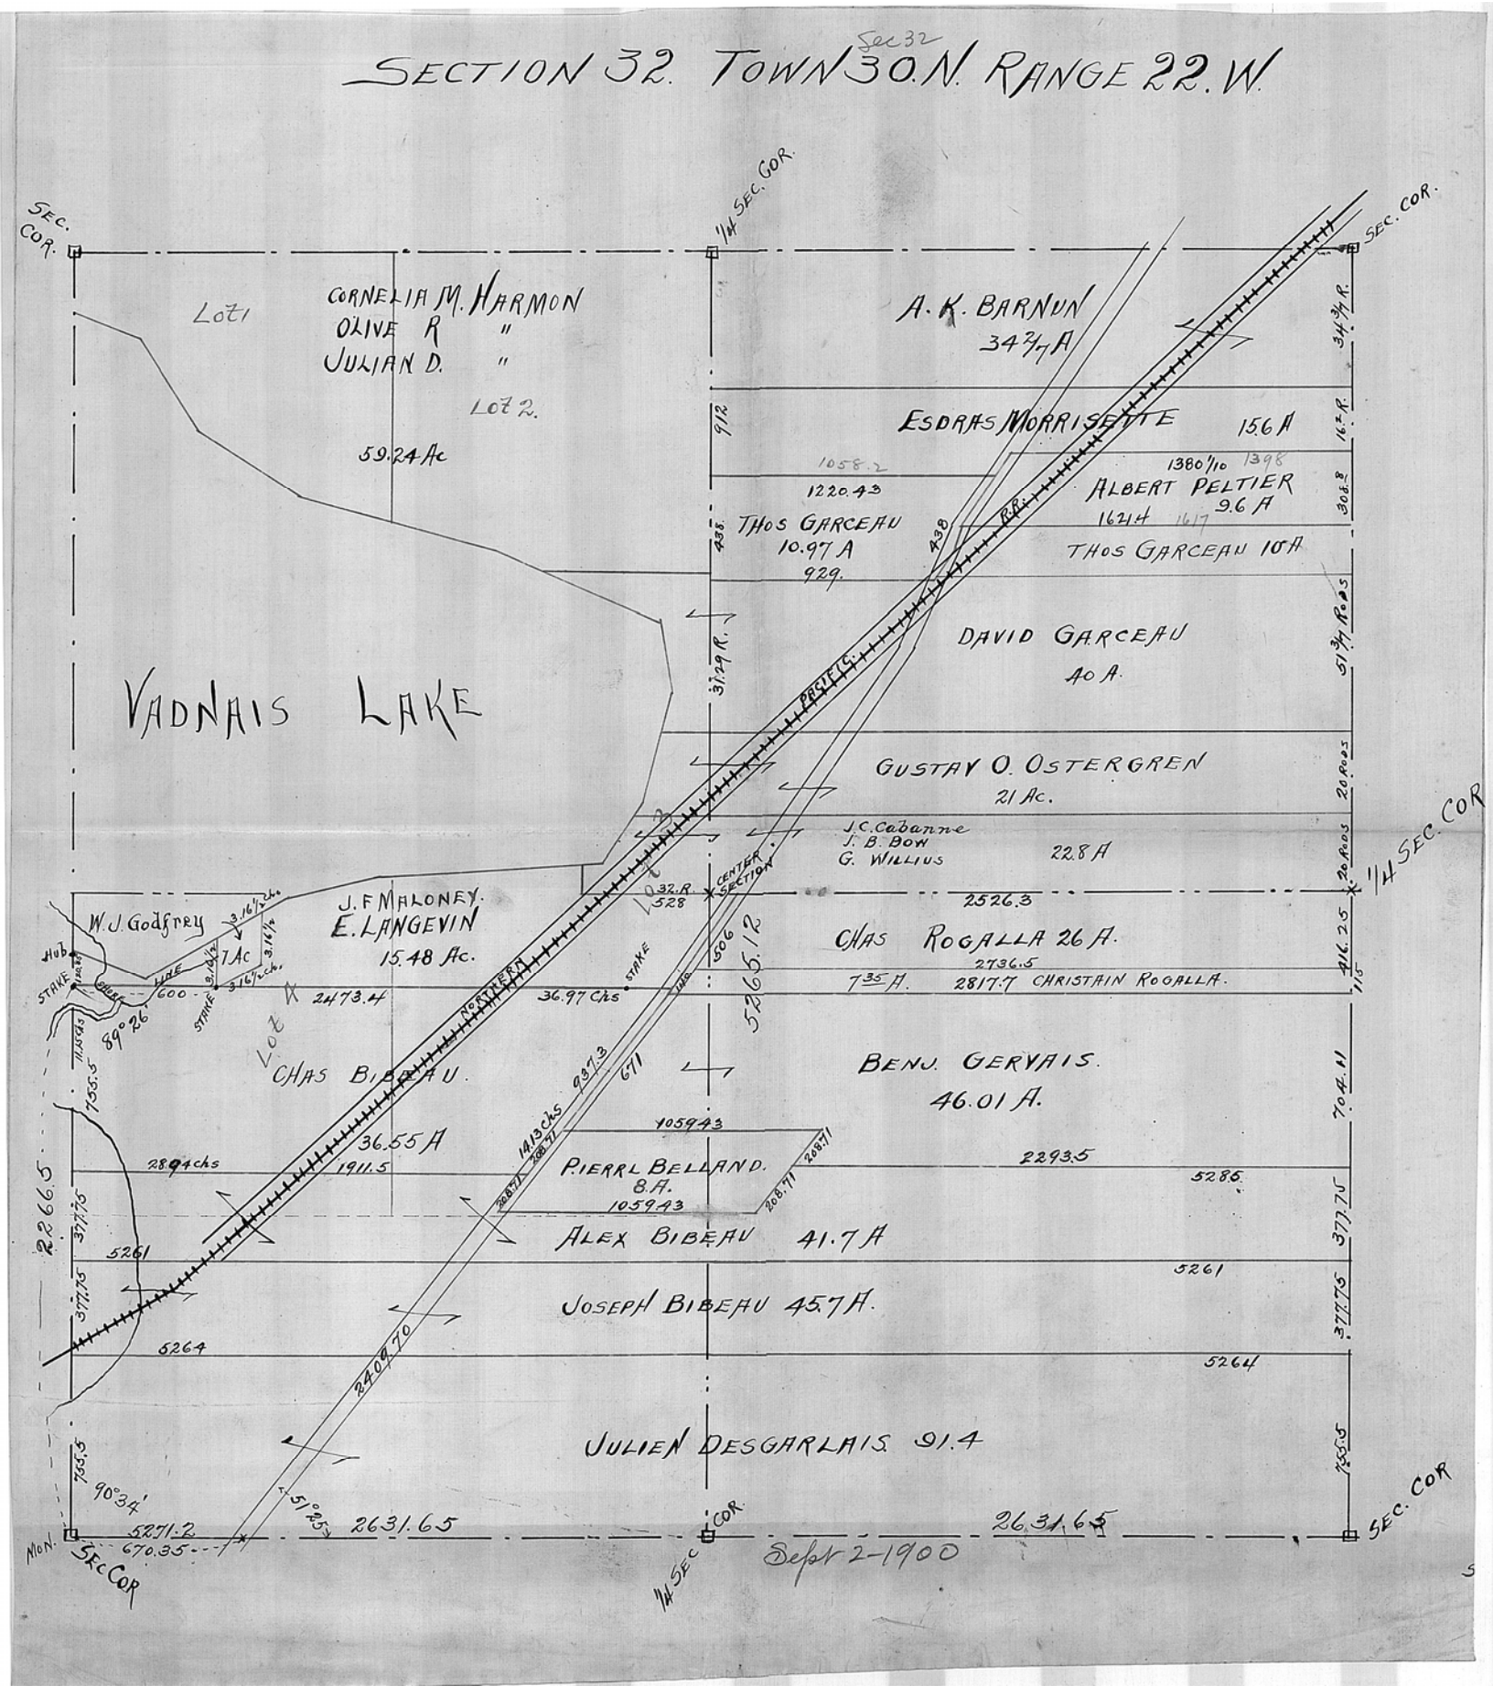
SECTION 32. TOWN 30 N. RANGE 22 W.
Sec 32
SEC. COR.
1/4 SEC. COR.
CORNELIA M. HARMON
OLIVE R "
JULIAN D. "
Lot 1
Lot 2.
59.24 Ac
A. K. BARNUN
34 2/7 A
ESDRAS MORRISETTE
15.6 A
1380 1/10
1398
ALBERT PELTIER
9.6 A
1621.4
1617
THOS GARCEAU
10.97 A
929.
1220.43
1058.2
THOS GARCEAU 10 A
DAVID GARCEAU
40 A.
VADNAIS LAKE
GUSTAV O. OSTERGREN
21 Ac.
J. C. Cabanne
J. B. Bow
G. Willius
22.8 A
CENTER SECTION
2526.3
J. F. MALONEY.
E. LANGEVIN
15.48 Ac.
W. J. Godfrey
7 Ac
CHAS ROGALLA 26 A.
2736.5
7 35 A.
2817.7 CHRISTAIN ROGALLA.
2473.4
36.97 Chs
Lot 4
CHAS BIBEAU.
36.55 A
1911.5
2894 chs
BENJ. GERVAIS.
46.01 A.
1059.43
PIERRL BELLAND.
8 A.
1059.43
2293.5
5285
ALEX BIBEAU 41.7 A
5261
JOSEPH BIBEAU 45.7 A.
5264
JULIEN DESGARLAIS 91.4
2409.70
2266.5
5265.12
2631.65
2631.65
5271.2
670.35
90°34'
51°25'
89°26'
MON.
SEC COR
1/4 SEC COR
Sept 2-1900