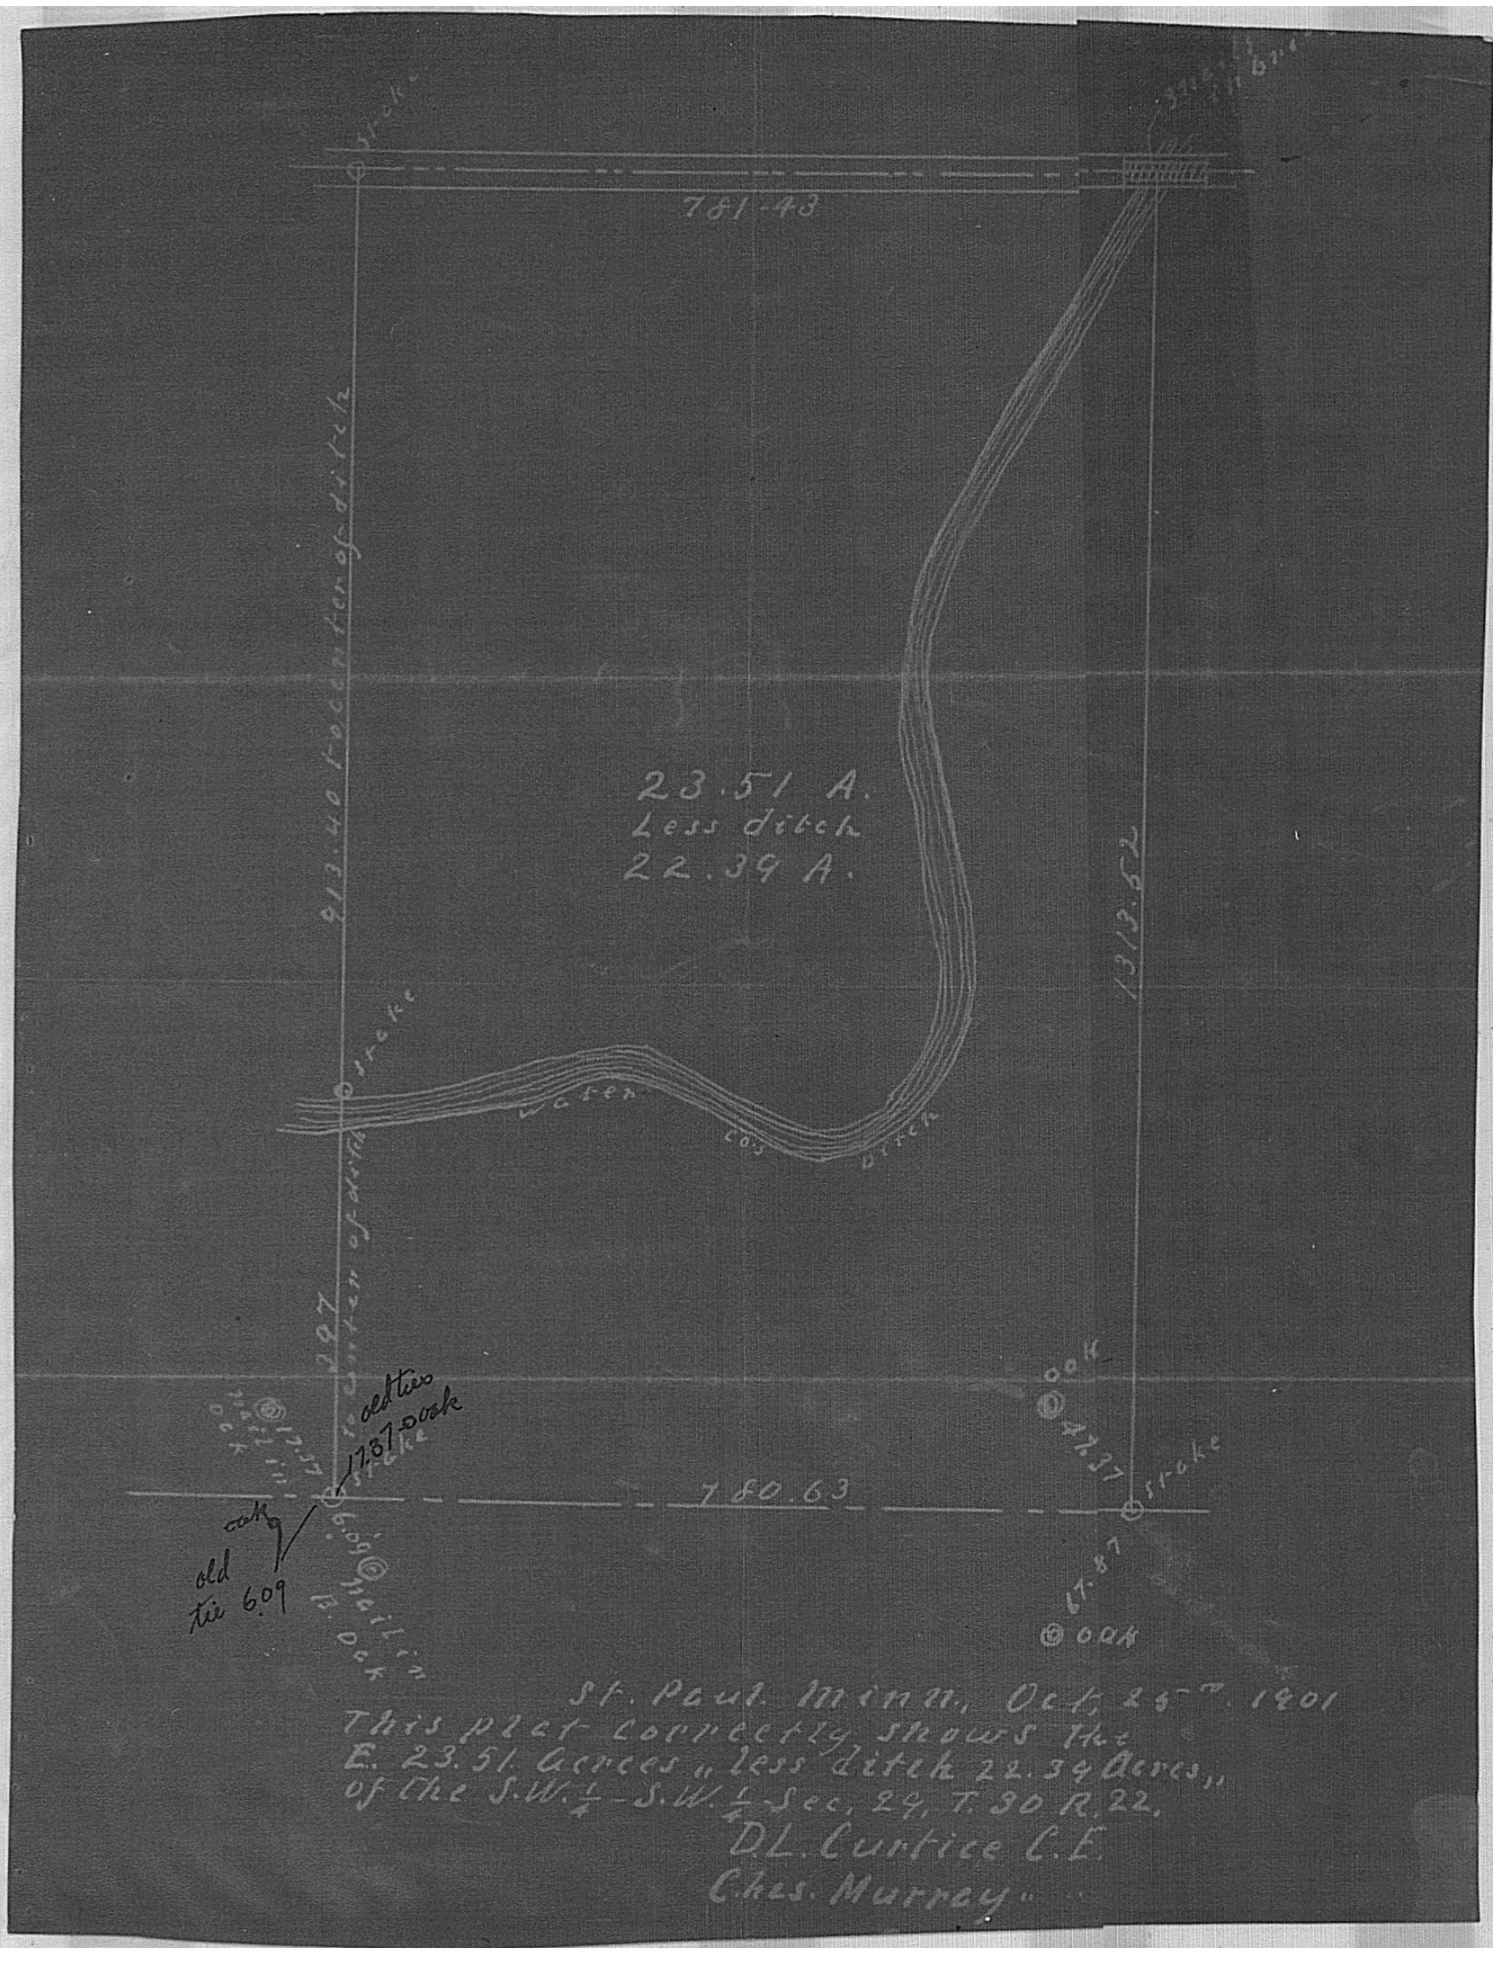
781.43
23.51 A.
Less ditch
22.39 A.
1313.52
780.63
stroke
stroke
stroke
stroke
Water
Ditch
Old tie 6.09
17.37 oak
oak
oak