


THE NORTH 10 ACRES OF LOT 5, SEC. 36  
T. 30, R. 23.

Scale 100 Feet pr. inch.

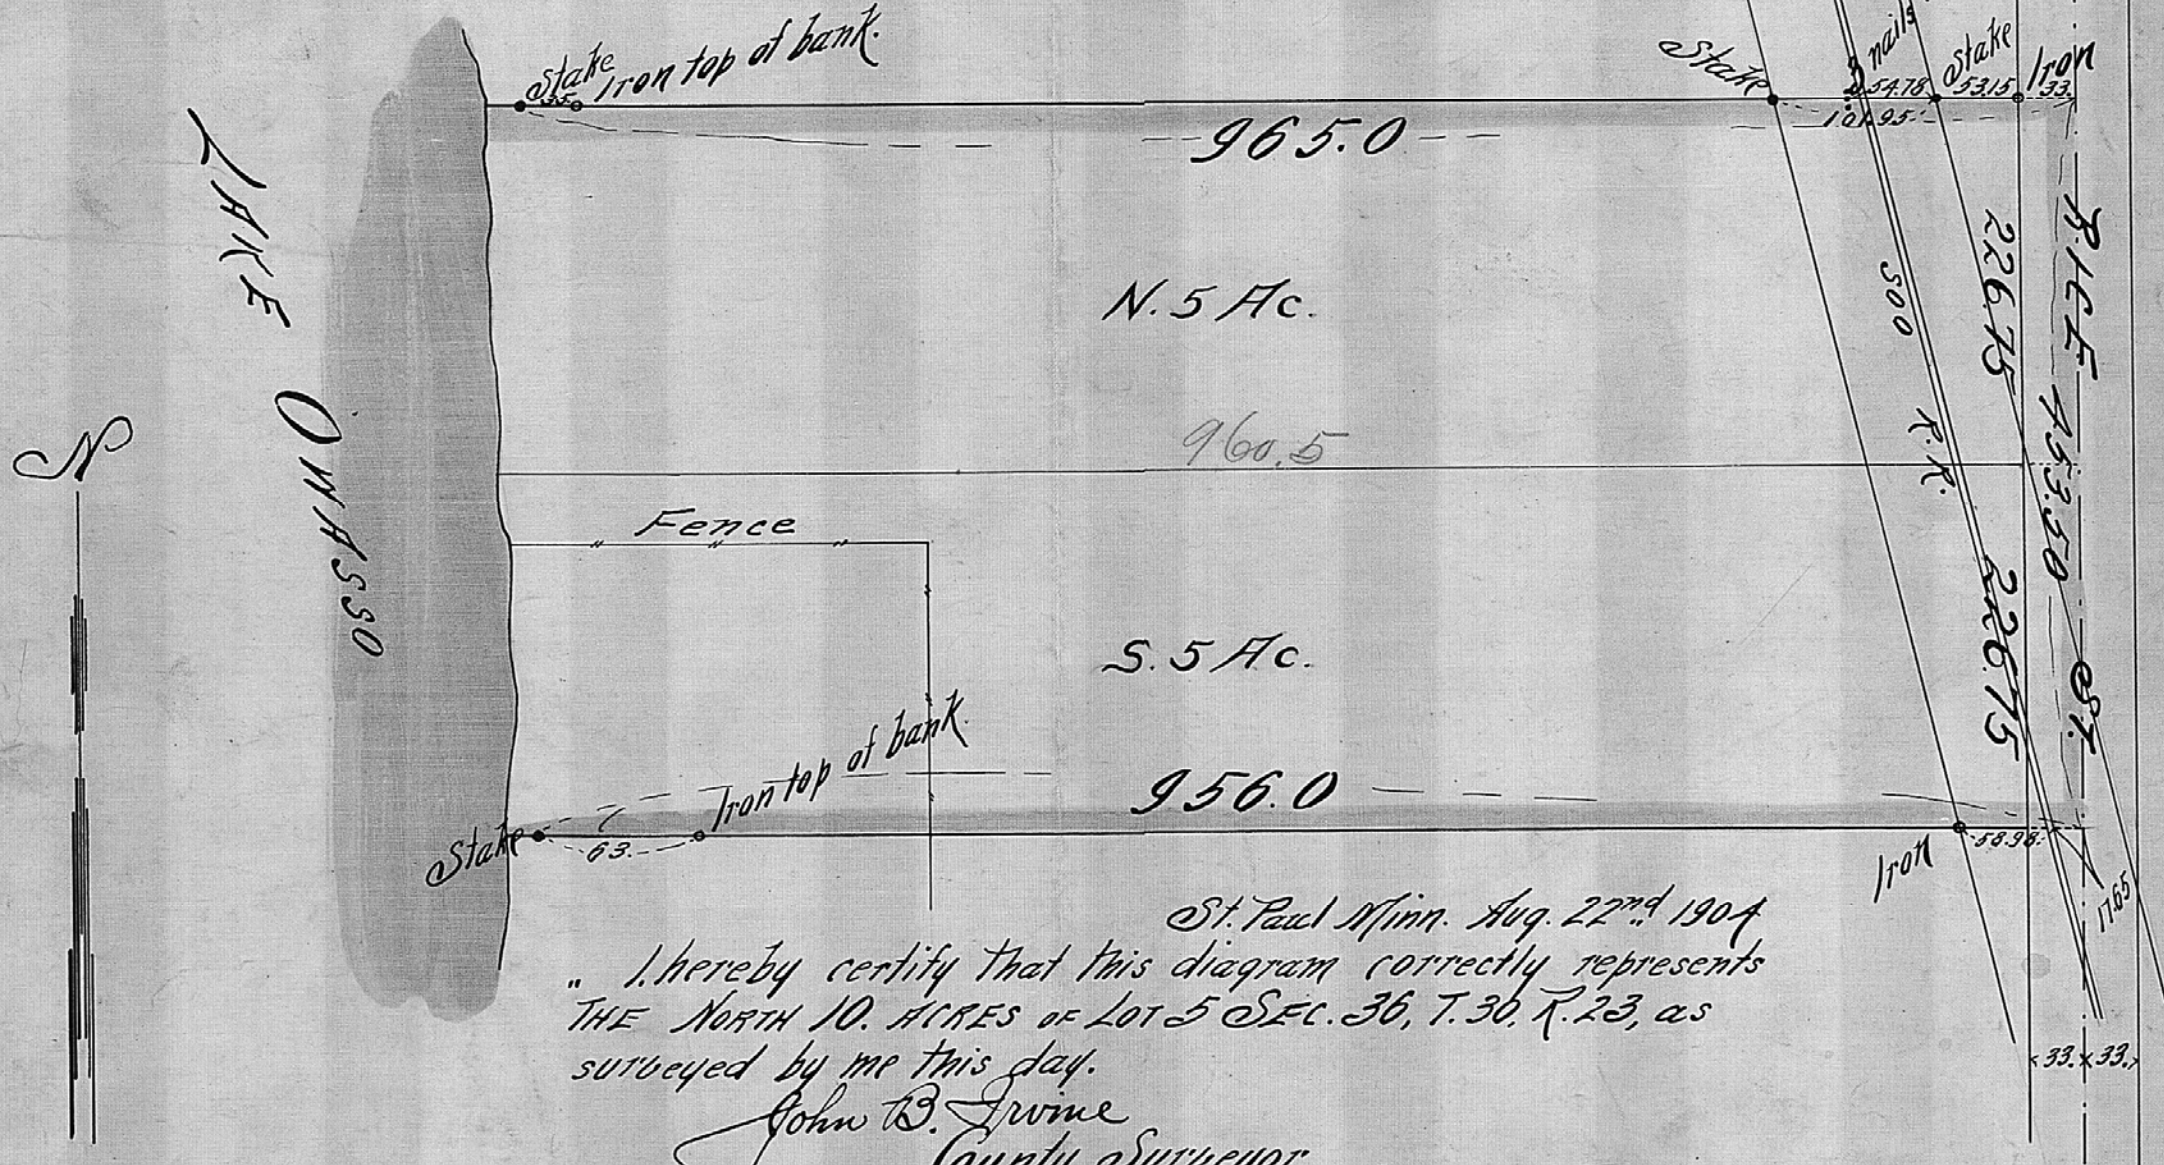

St. Paul Minn. Aug. 22<sup>nd</sup> 1904  
I hereby certify that this diagram correctly represents  
THE NORTH 10. ACRES OF LOT 5 SEC. 36, T. 30, R. 23, as  
surveyed by me this day.

John B. Irvine  
County Surveyor  
Room 16 Court House

Aug 22 1904