


LOTS 27 & 28 BLOCK 1  
BERGHOLTZ'S SUB. OF LOTS 2, 6, 10, 11, 14 & 15  
BAZILLE'S ACRE LOTS

Surveyed May 10<sup>th</sup> 1902

scale 20 feet per inch

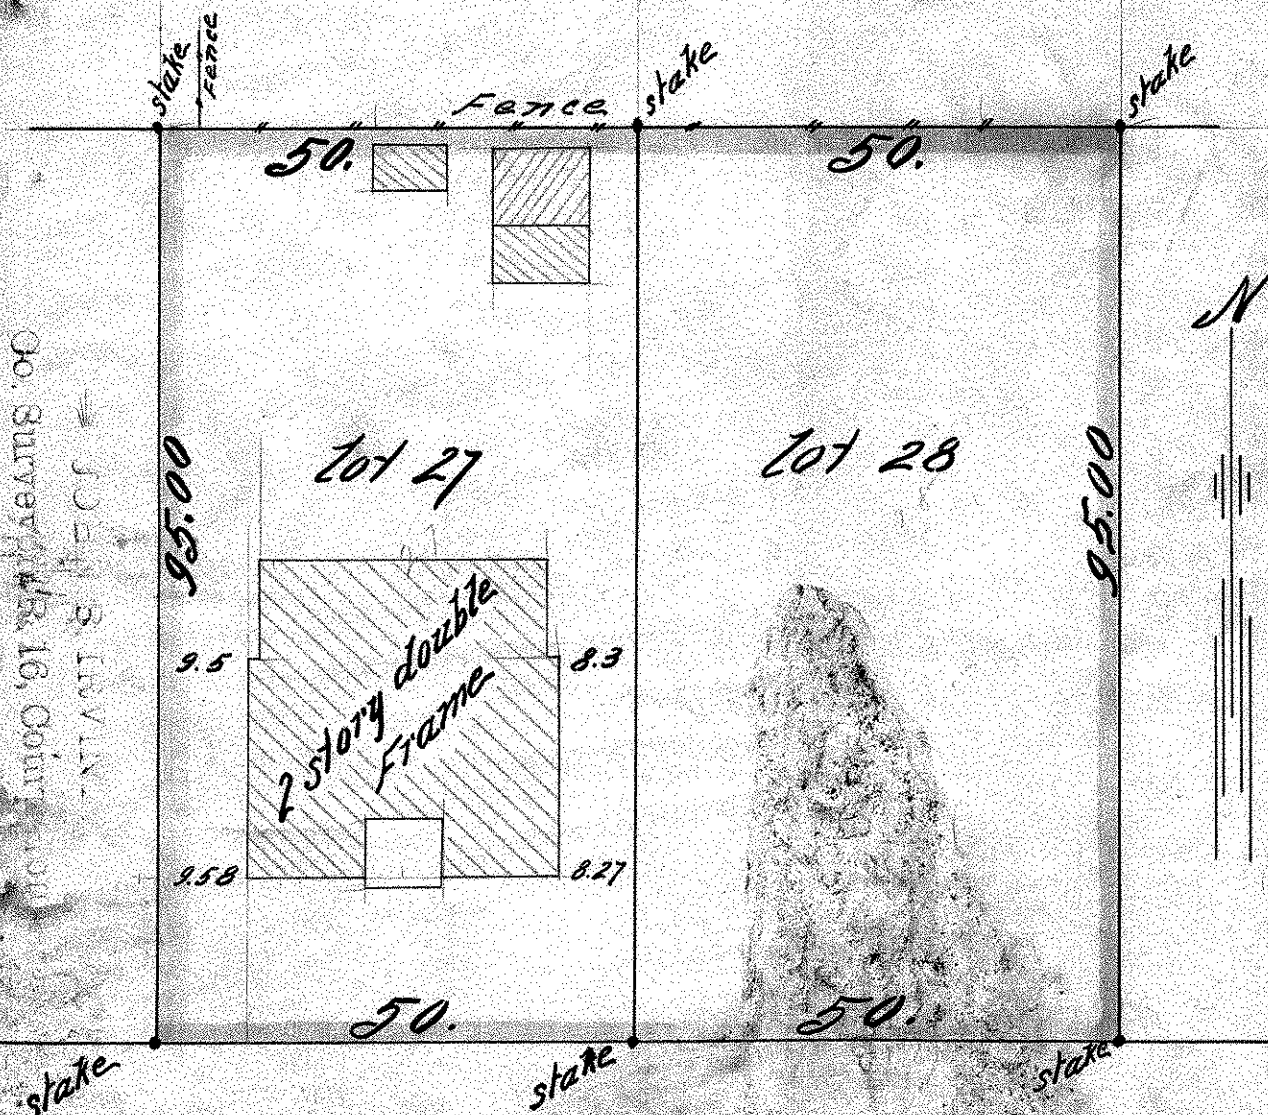

JOHN B. IRVING  
Co. Surveyor, R. 16, Co. 10

LITCHFIELD ST  
75. ST  
1 B. 47. P. 9.