


Lots 3, 4 AND 5 BLOCK 13
 BAZILLE & ROBERTS ADDITION
 scale 20 feet per inch
 surveyed Sept 15, 1902.

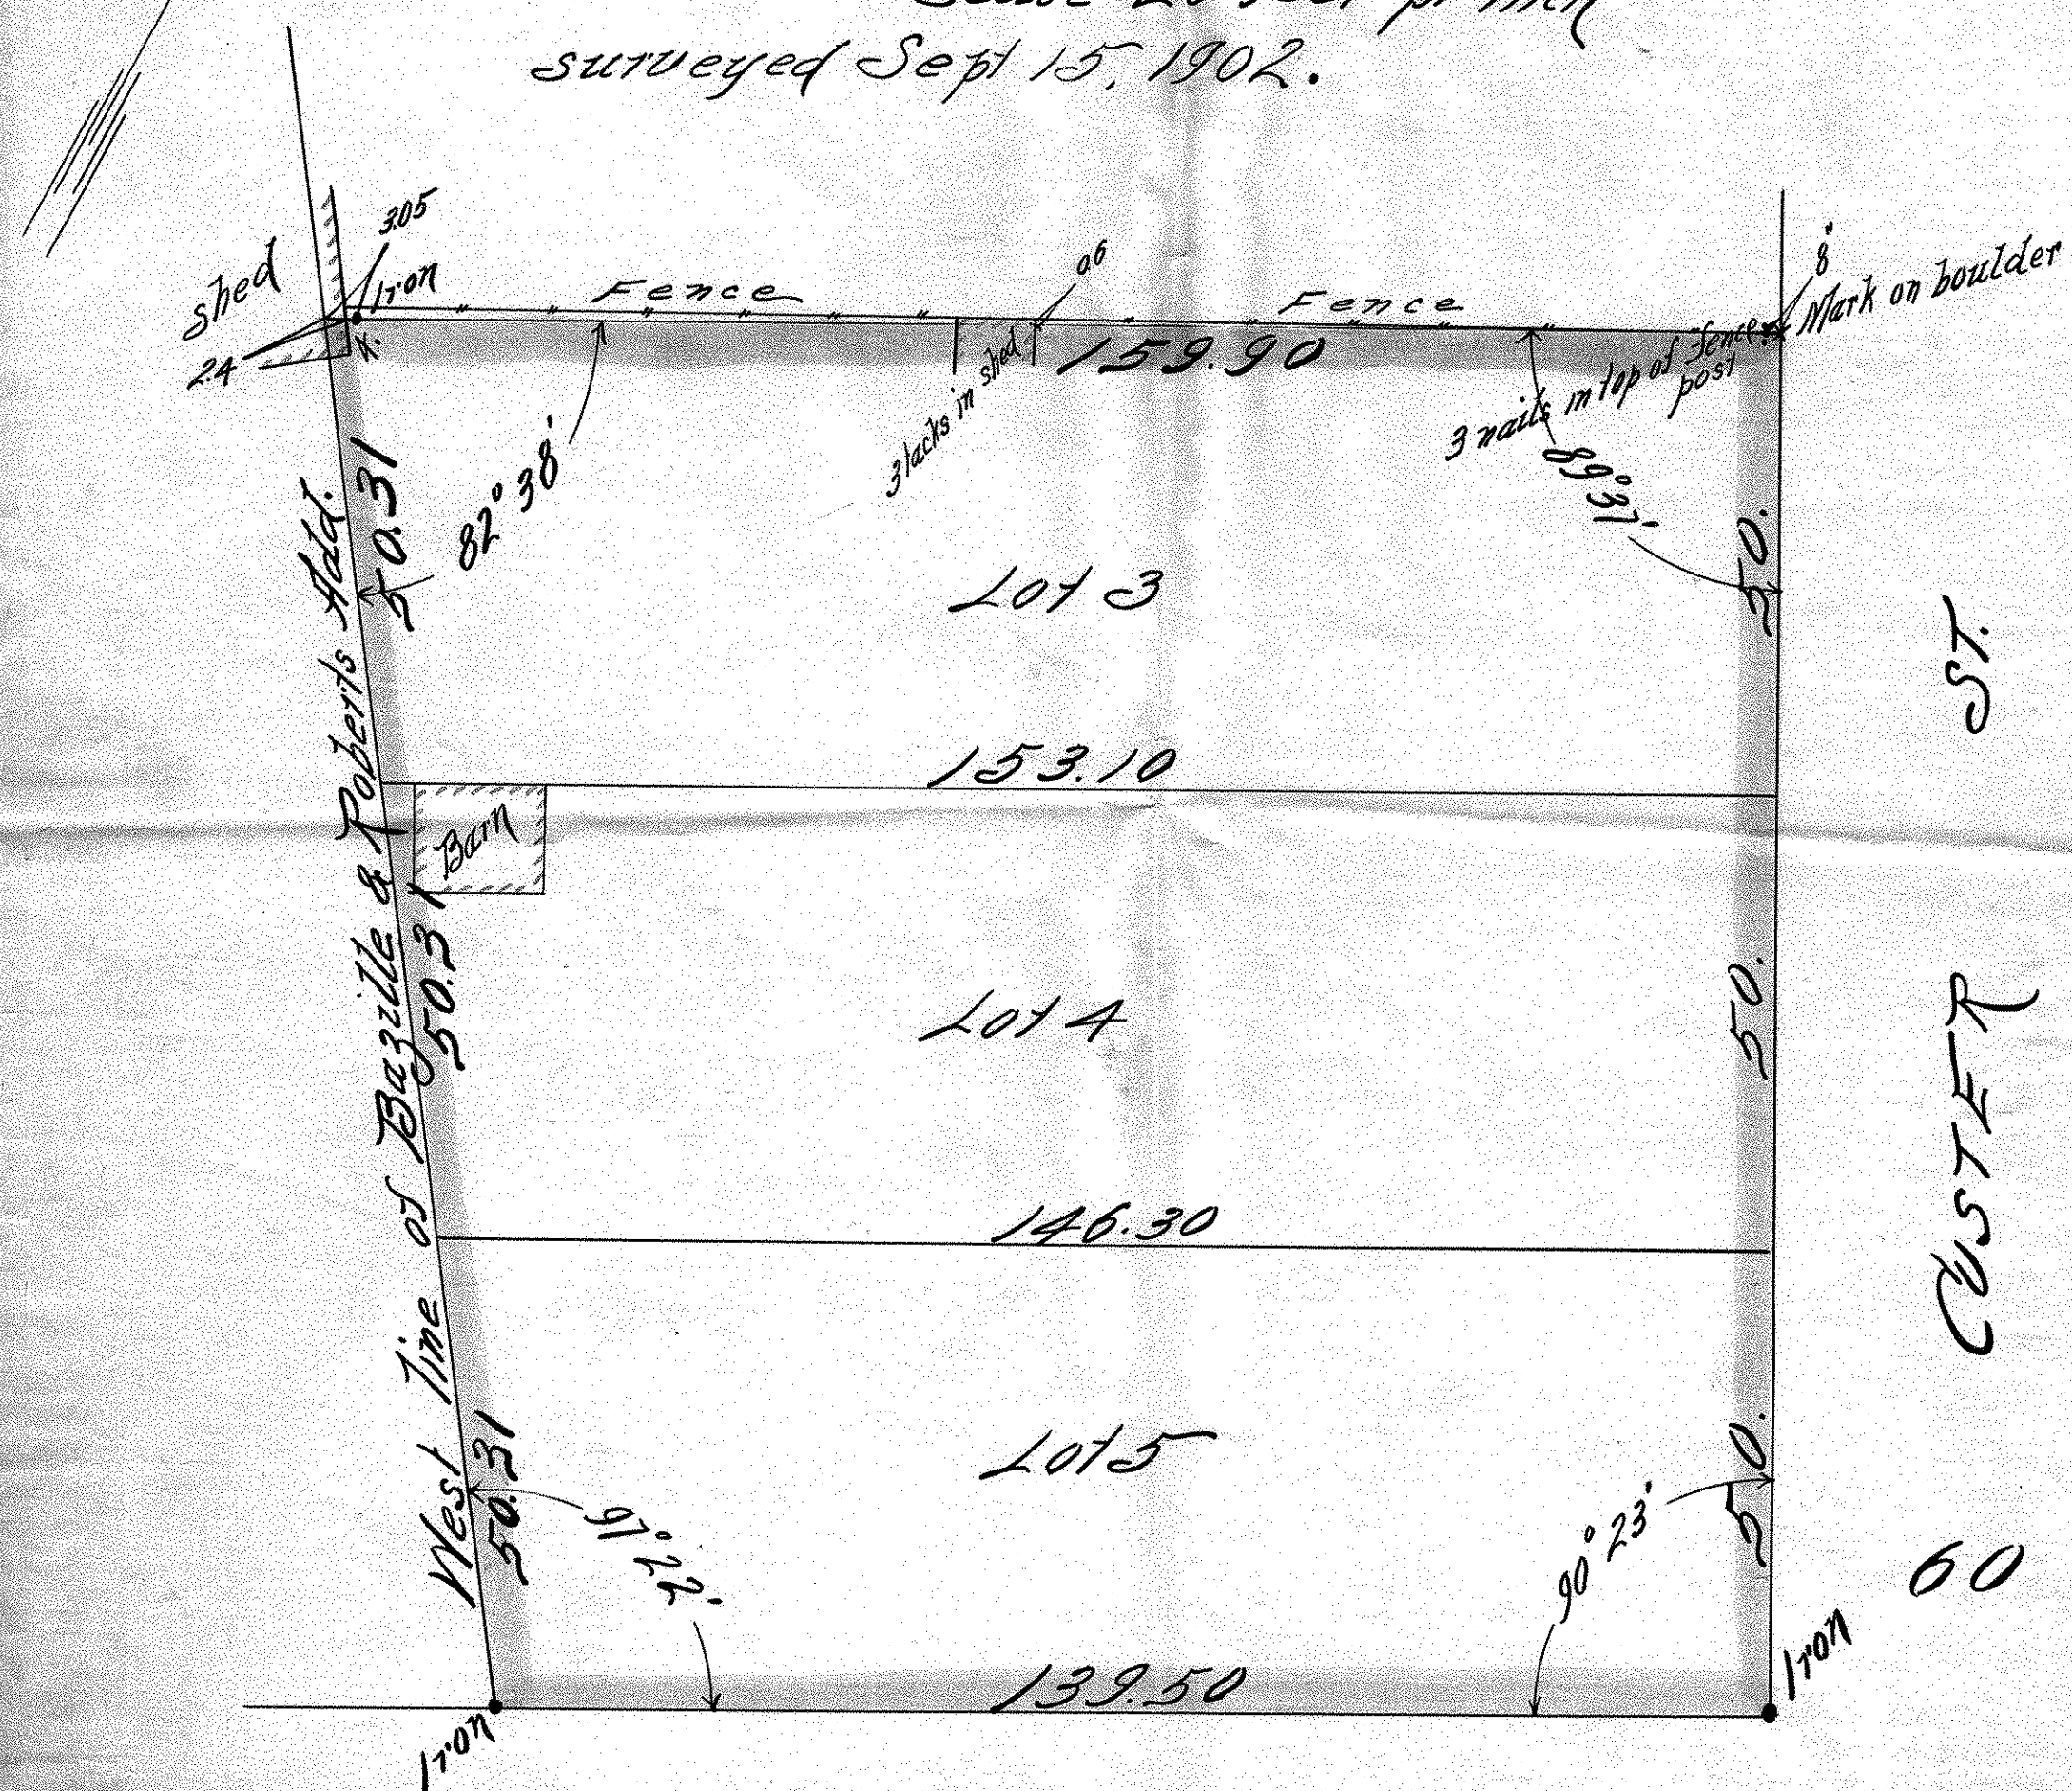

B47 P. 76

CHICAGO AVE 60