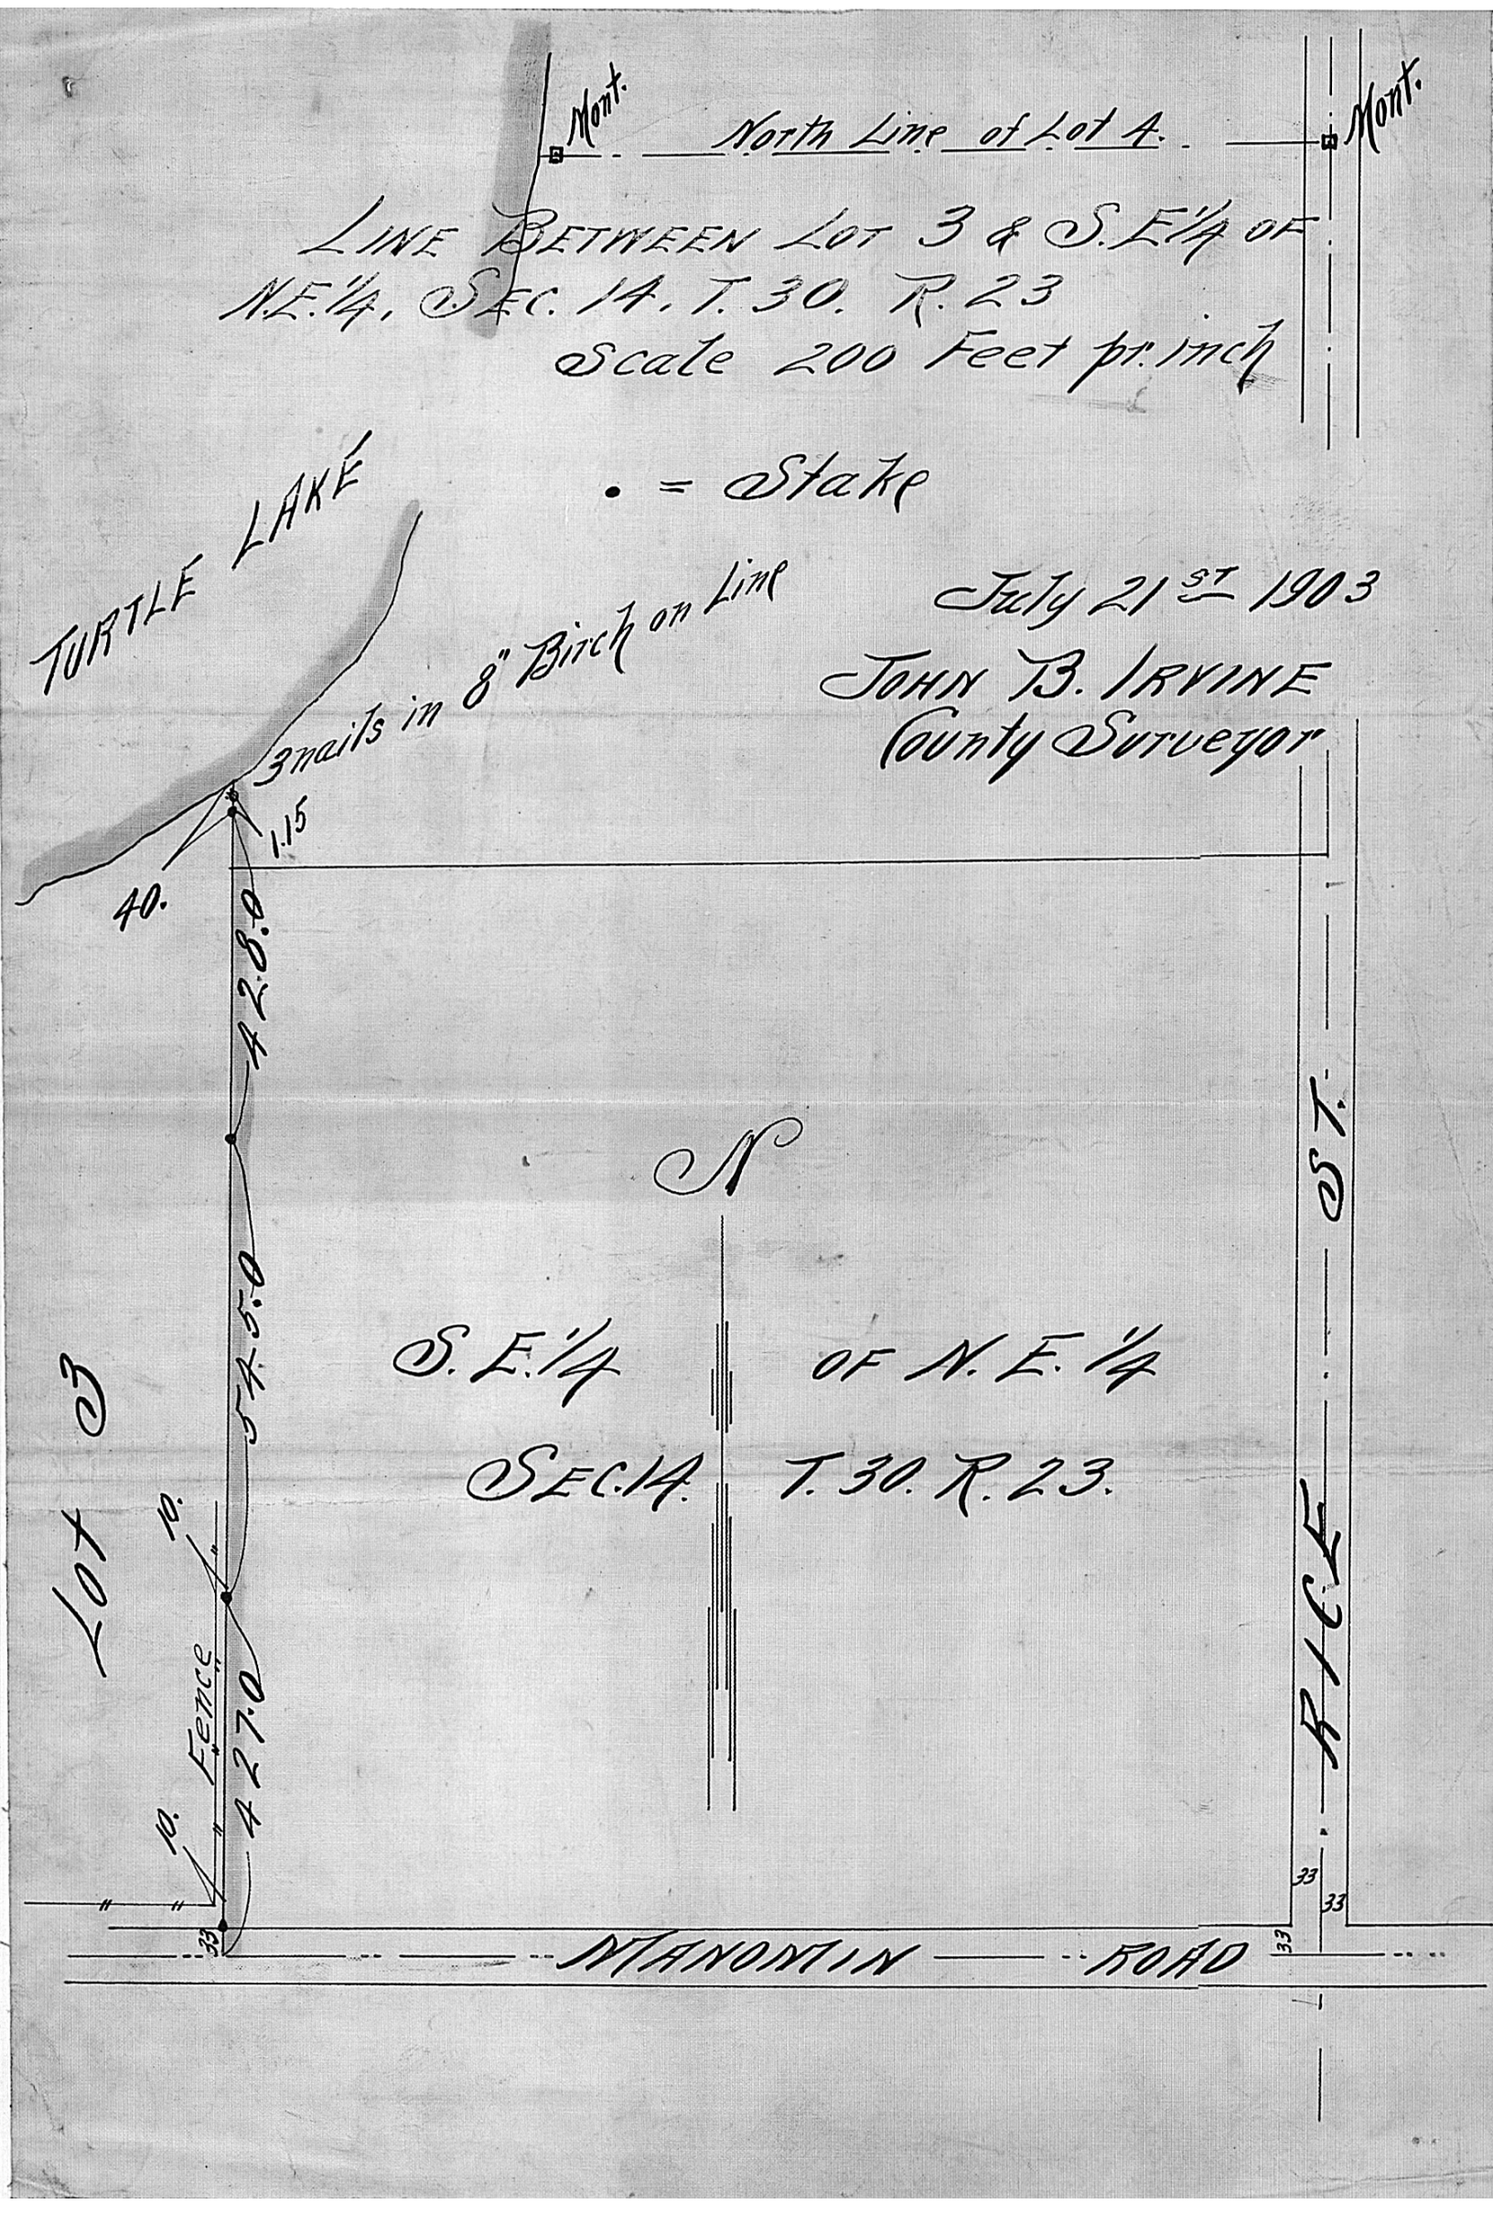
Mont.
North Line of Lot 4.
Mont.
LINE BETWEEN LOT 3 & S.E¼ OF N.E¼. SEC. 14. T. 30. R. 23
Scale 200 Feet pr. inch
• = Stake
TURTLE LAKE
July 21st 1903
JOHN B. IRVINE
County Surveyor
3 nails in 8" Birch on Line
1.15
40.
A 28.0
A 15.0
A 27.0
10.
10. Fence
S
S.E¼ OF N.E¼
SEC. 14. T. 30. R. 23.
LOT 3
RICE ST.
33
33
33
MANOMIN ROAD