


N.E. 1/4 SEC. 21, T. 30, R. 23.

Scale 300. Feet pr. inch

May 22nd '03 Jos. Schutte

- ind. Mont.
- " stake

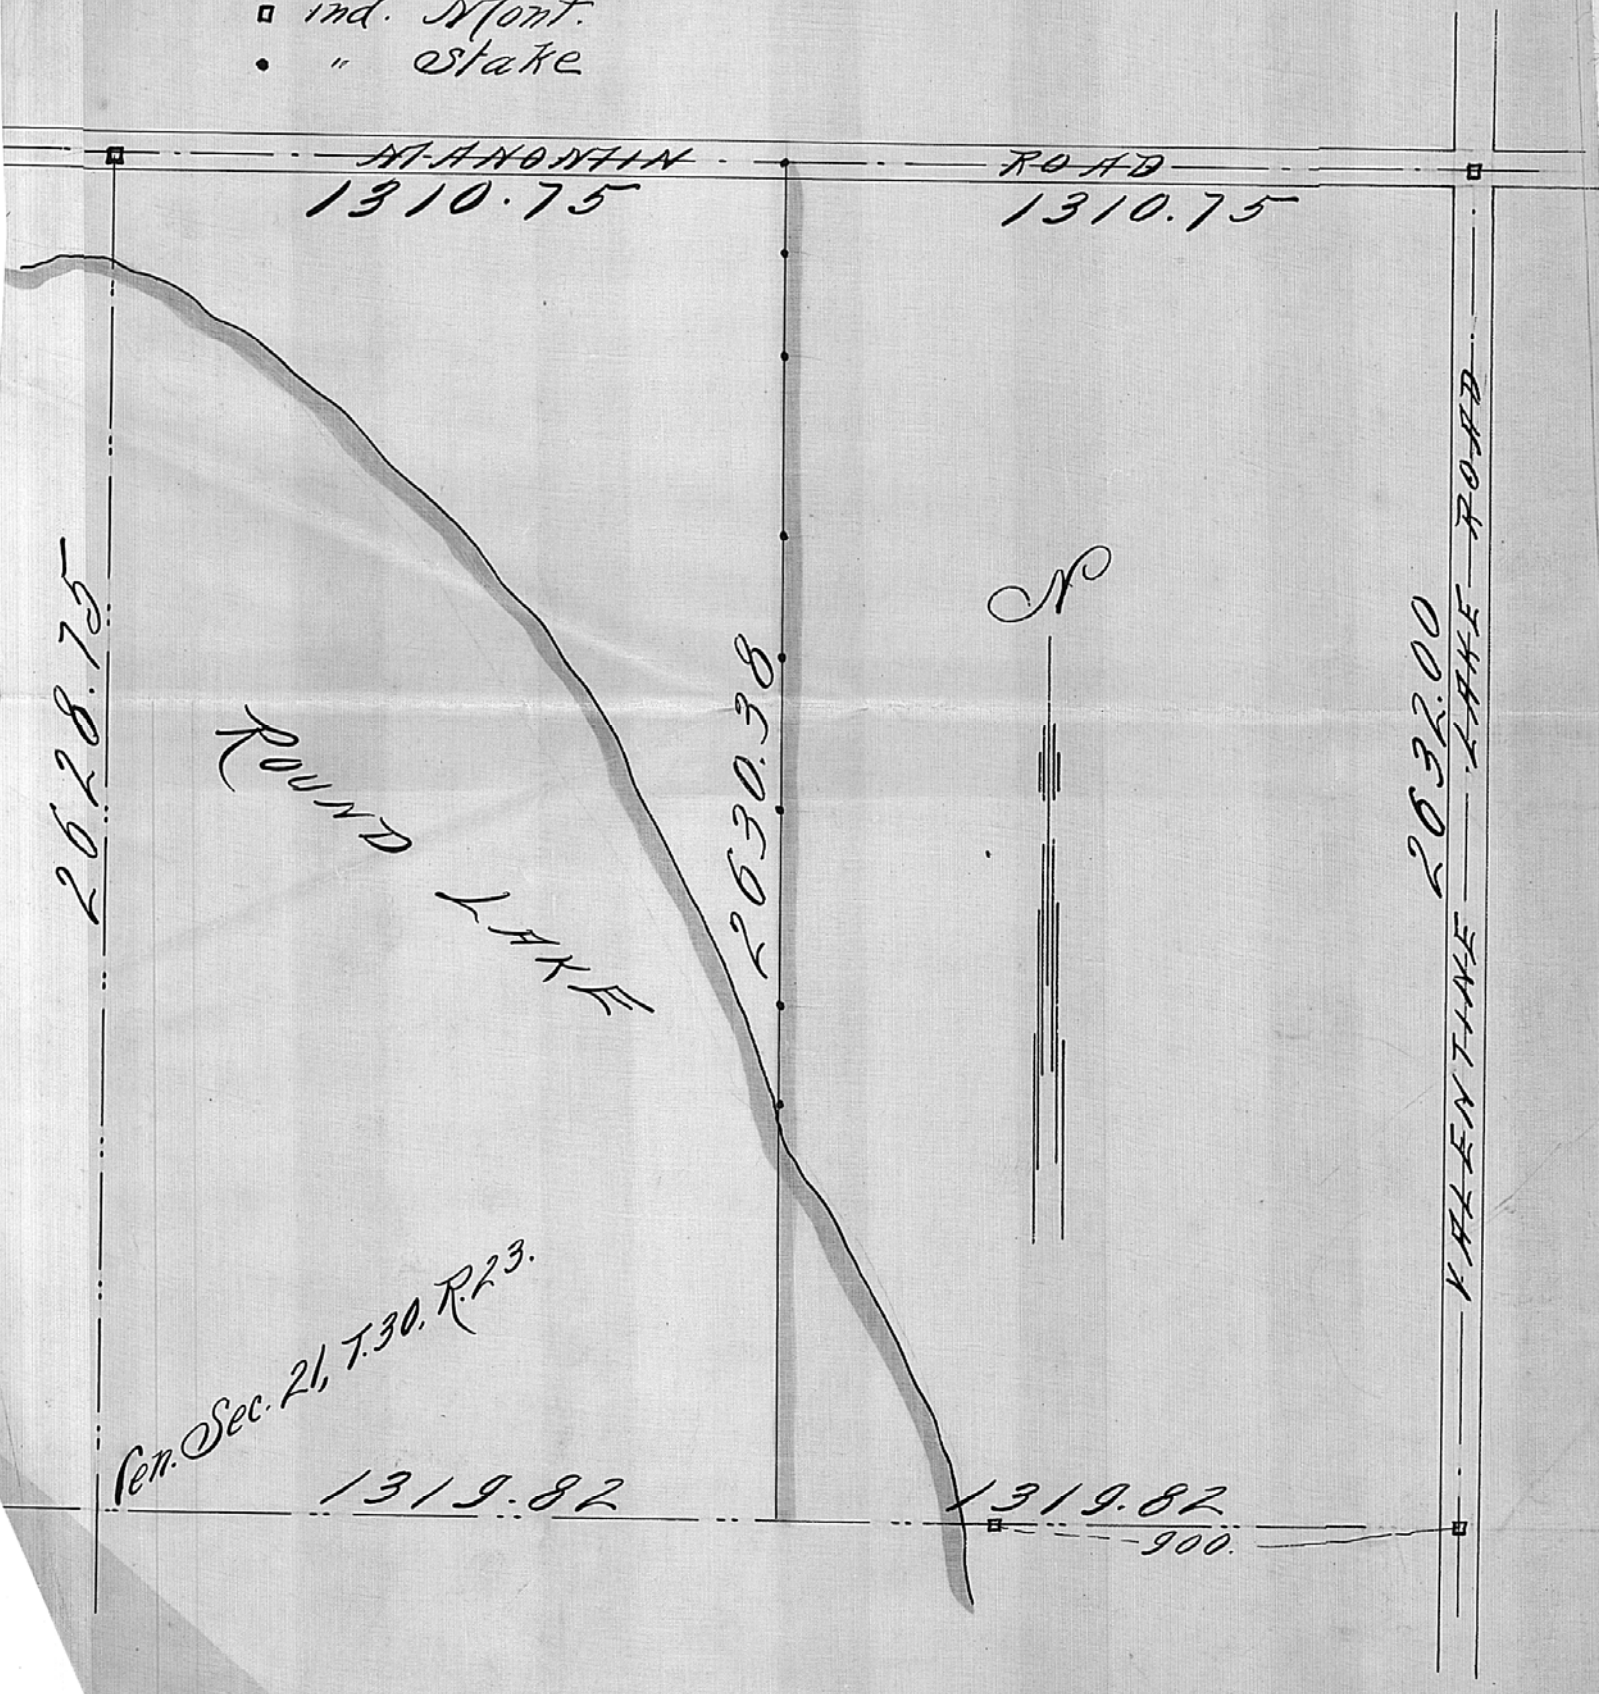

N.E. 1/4 SEC. 21, T. 30, R. 23.

N