


1618 AUDITOR'S SUBDN. No. 4
SUR. March 17th 1903 For A. Stook

TERRITORIAL ROAD

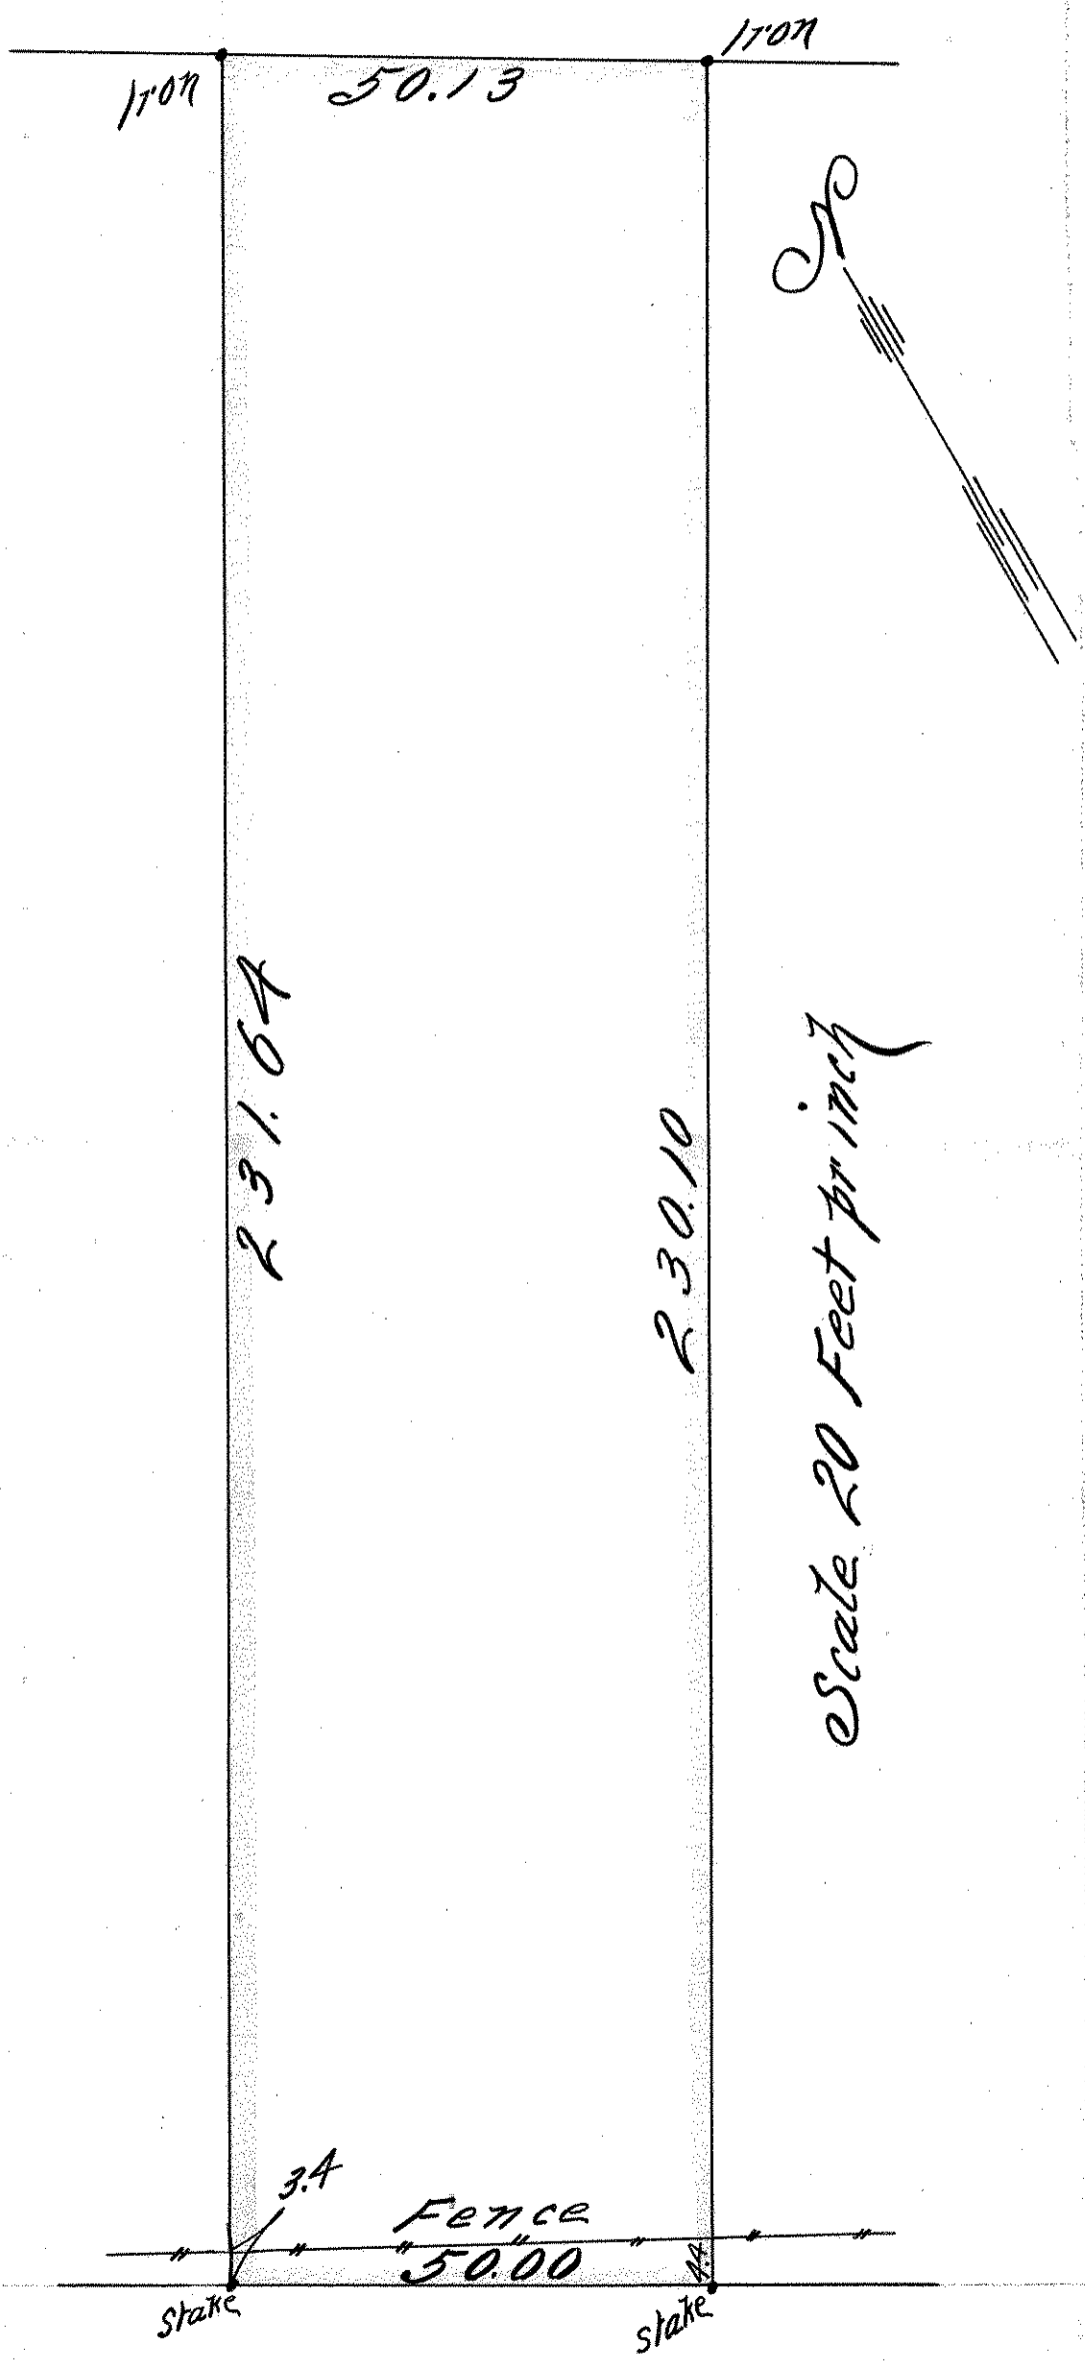

B. 53. P. 64