LOT 26 BLOCK 3 BORUP & PAYNE'S ADDITION
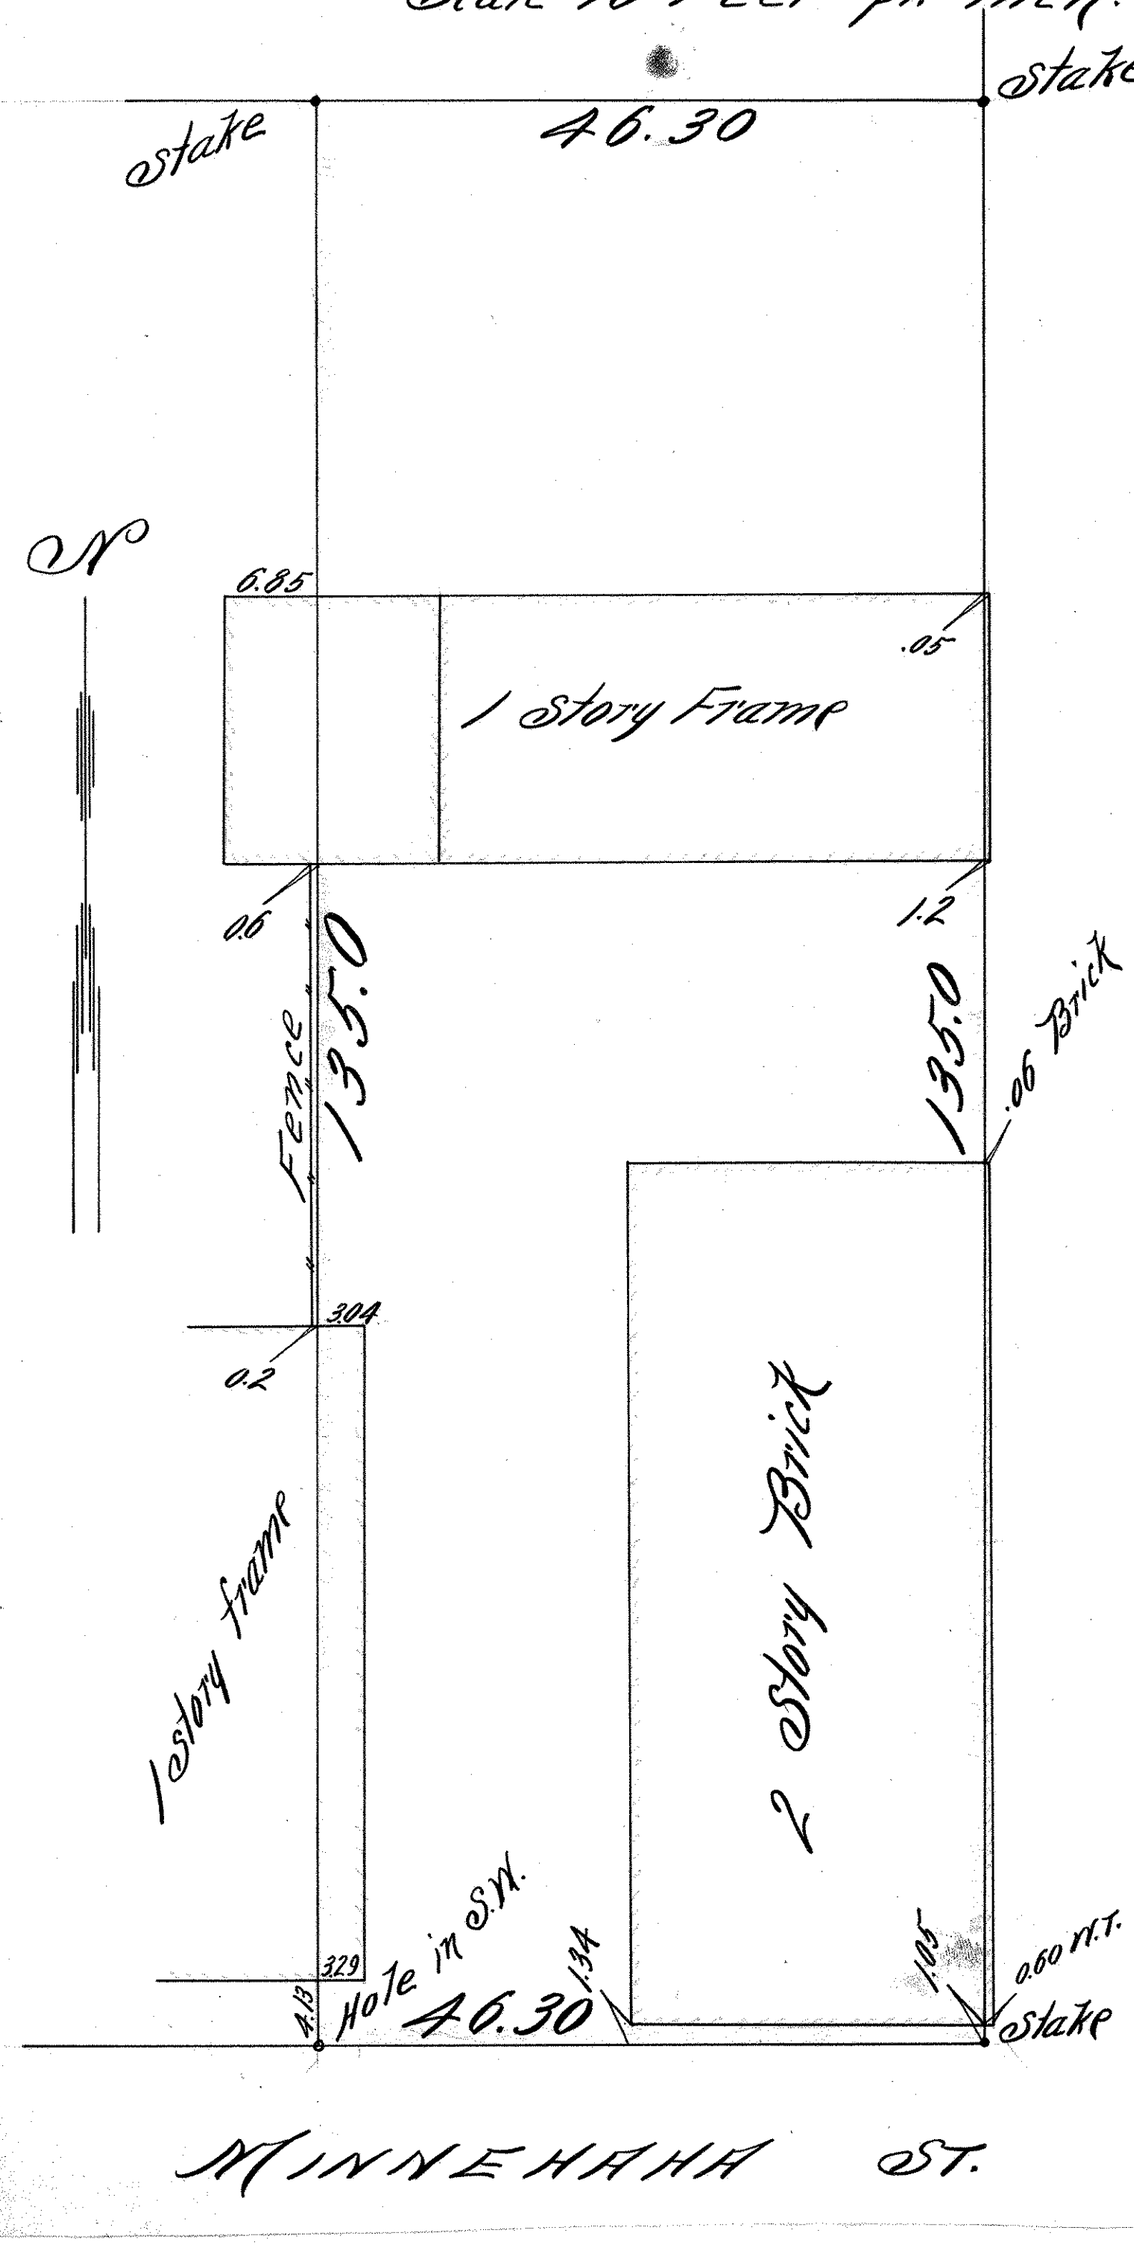
Scale 10 Feet pr. inch.