BRAATZ PLACE

ST. PAUL MINN.

Surveyed April 11th 1903

John B. Irvine Surveyor.

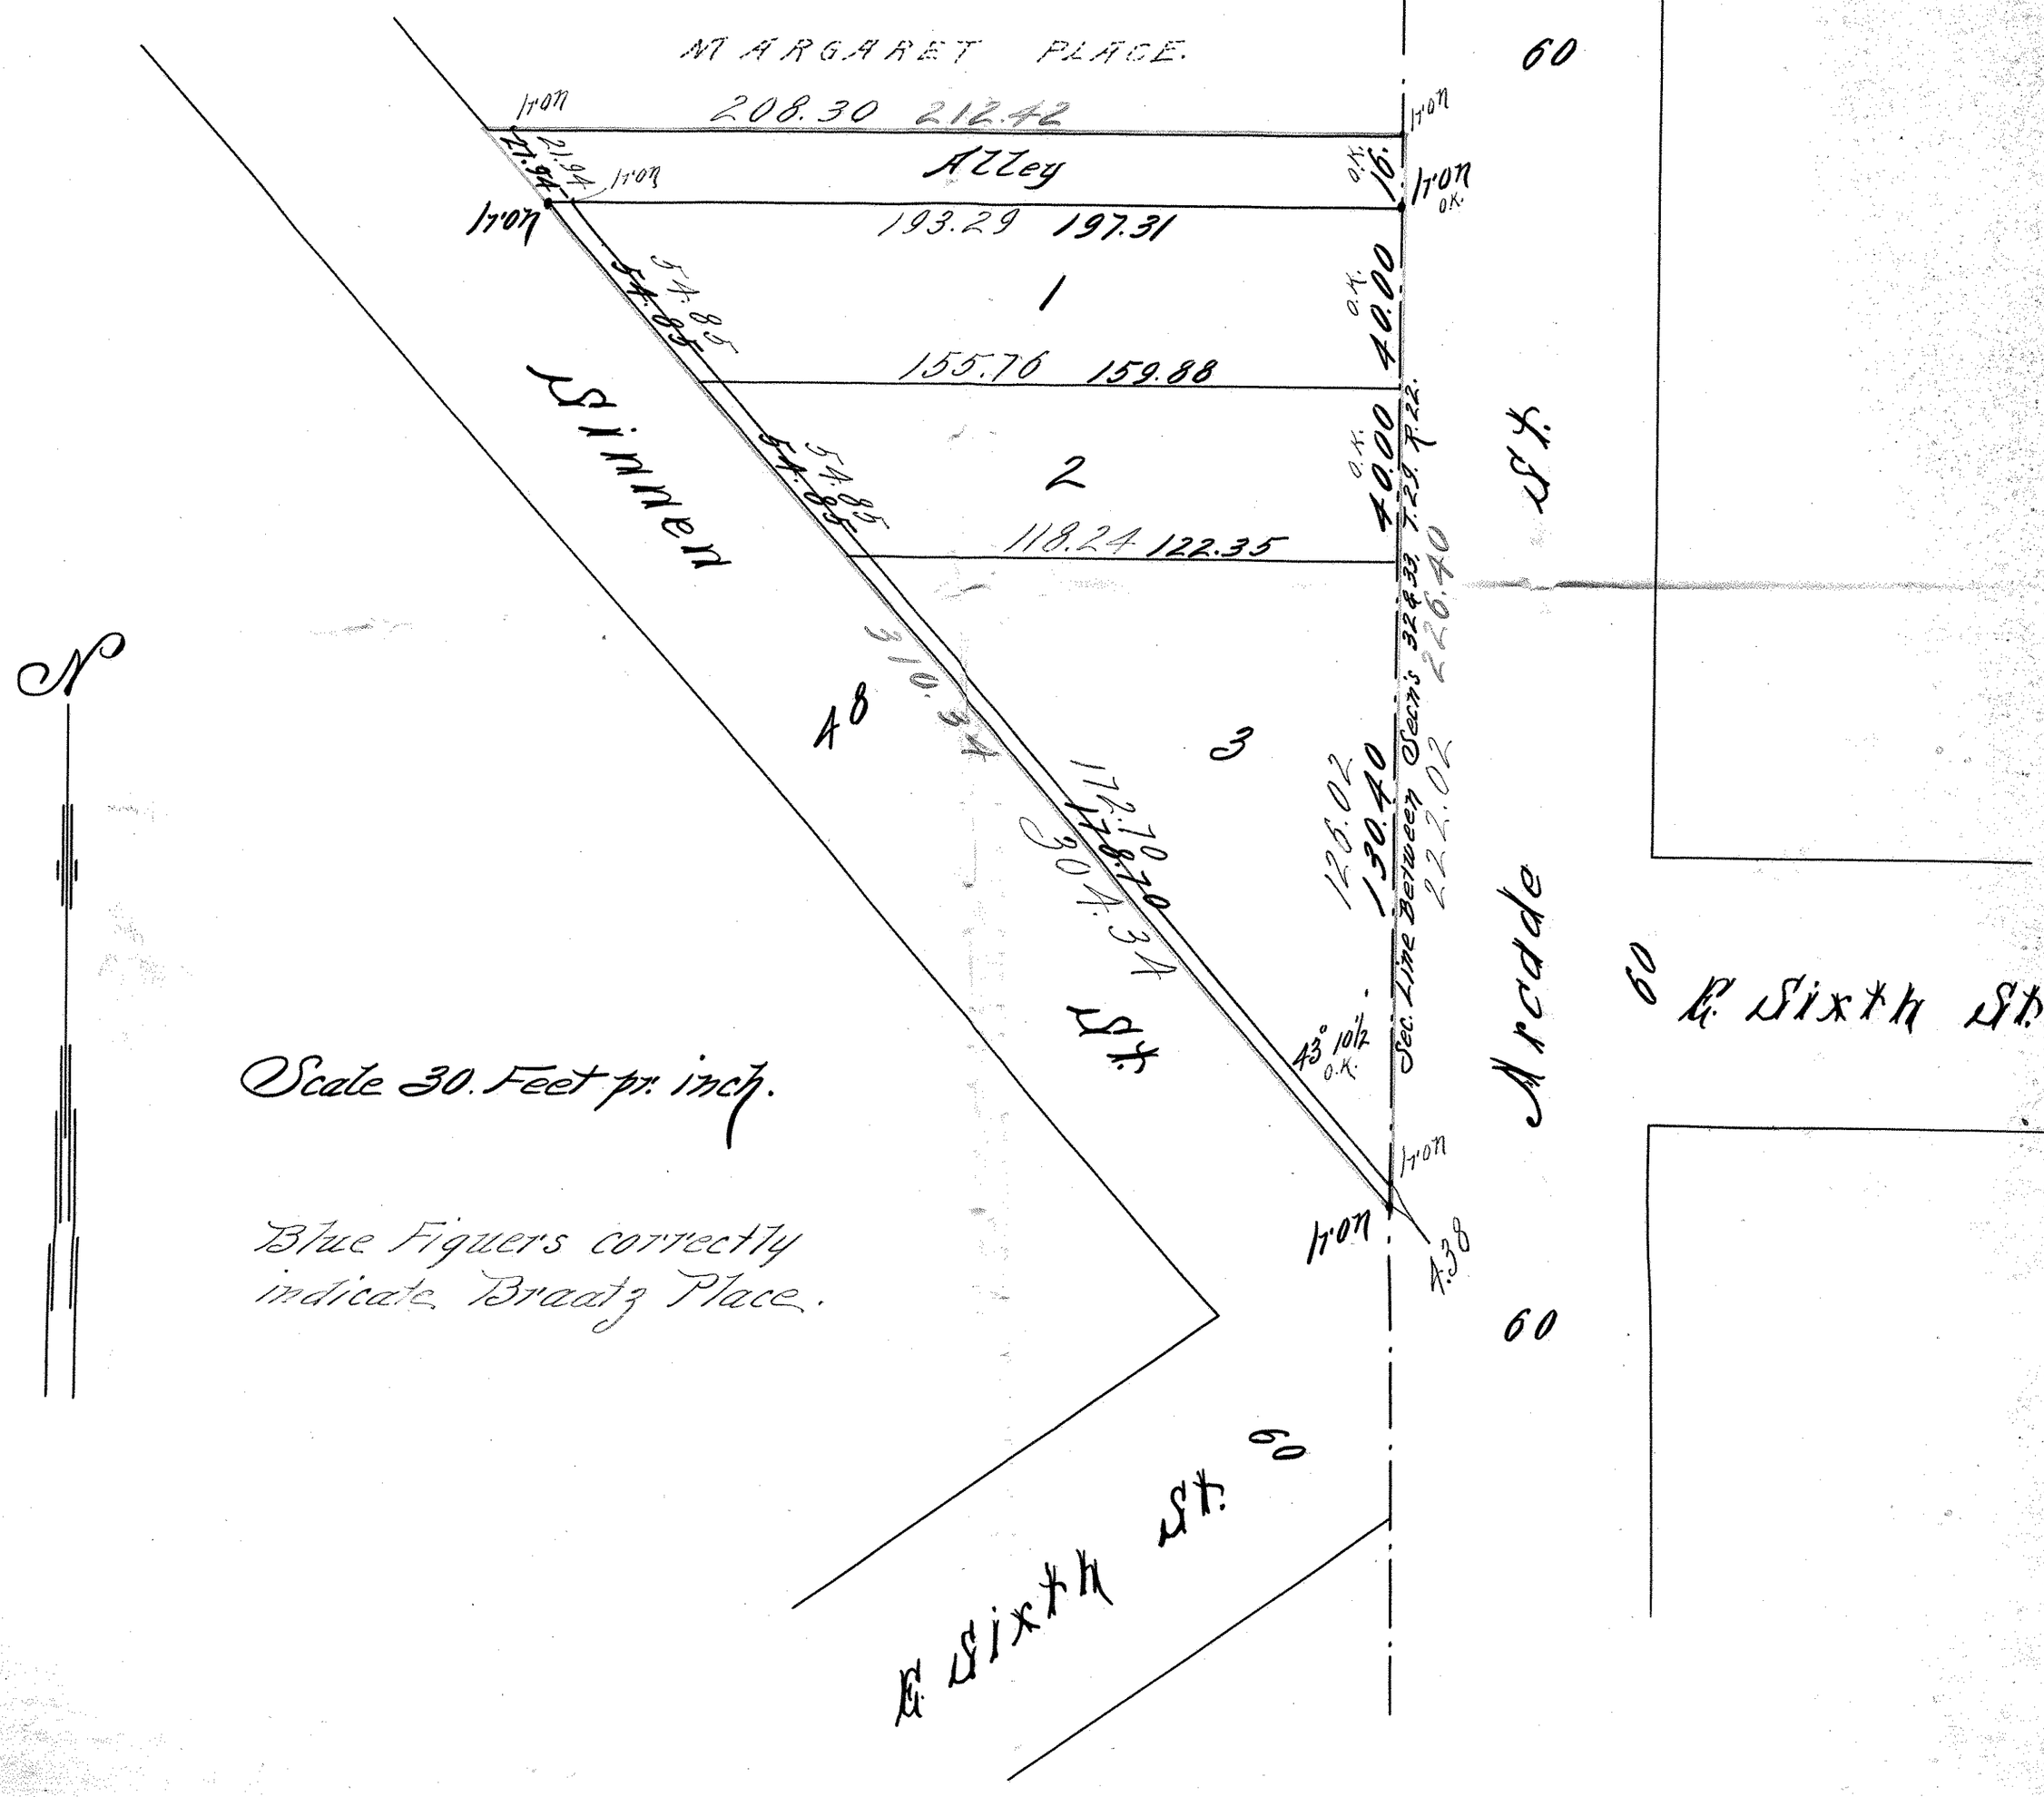

Scale 30. Feet pr. inch.

Blue Figuers correctly indicate Braatz Place.