


LIVINGSTON AVE.

LOT 10 BLK 15 BAZILLE & ROBERTS ADD.

INDIANA

AVE

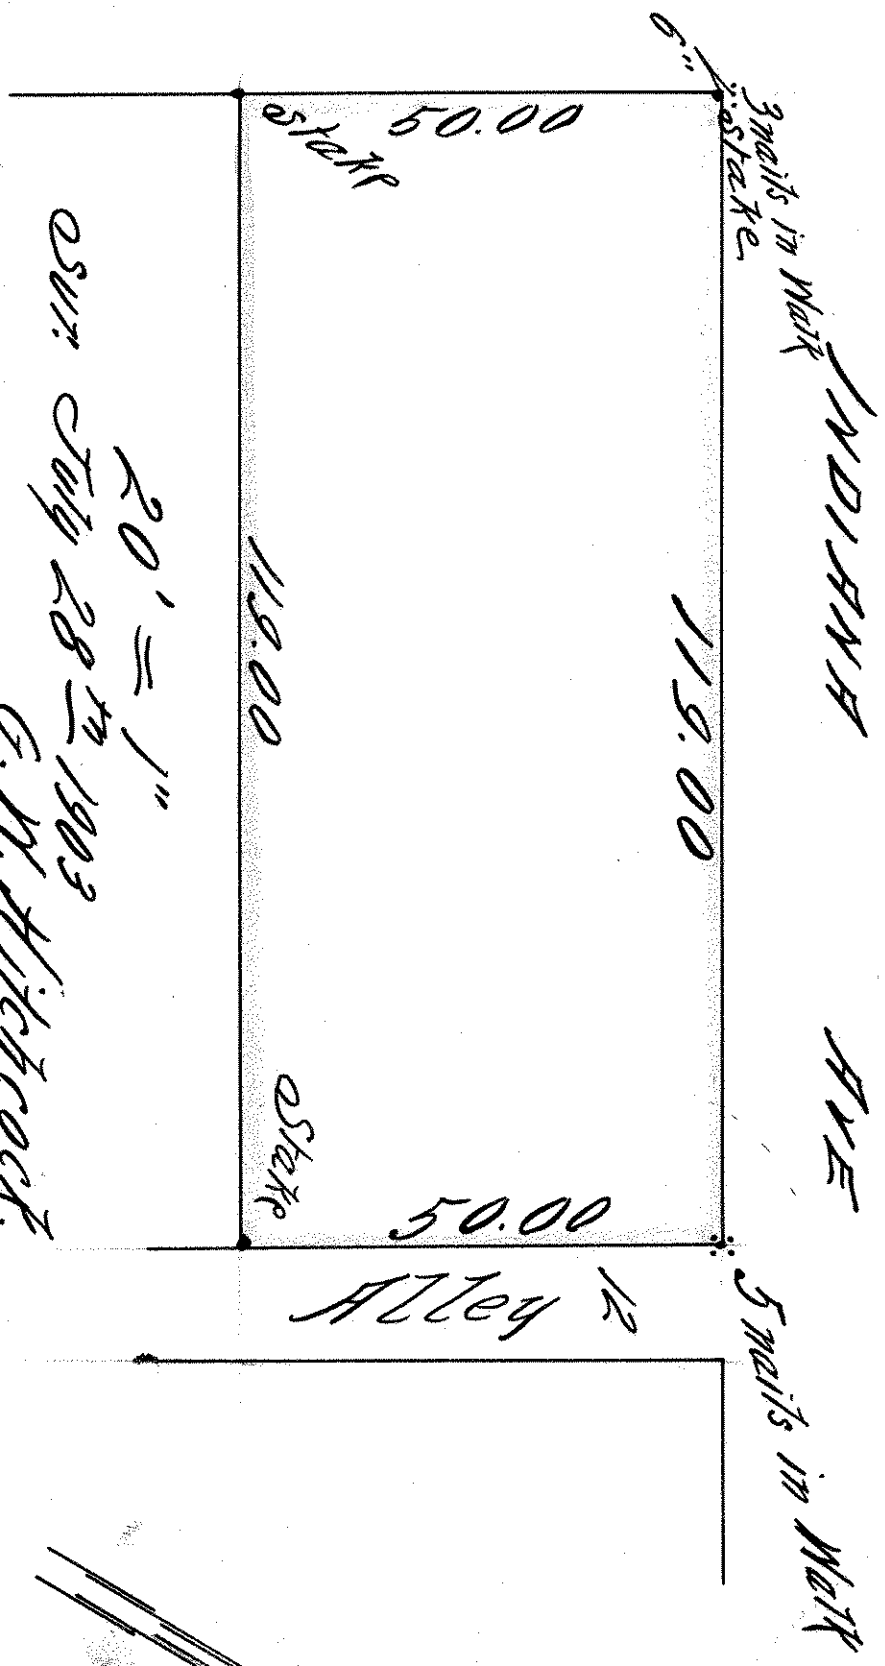

20' = 1"  
 SURV. July 28<sup>th</sup> 1903  
 G. W. Hitchcock.

