

LOT 1 BLOCK 13 BRIVILLE AND ROBERTS ADD.  
SURV. MAP. 1979 1903 FOR R. M. LANTON  
20. ft. per inch.


INDIANA

AVE.

CUSTER ST.

SP

3 nails in Walk

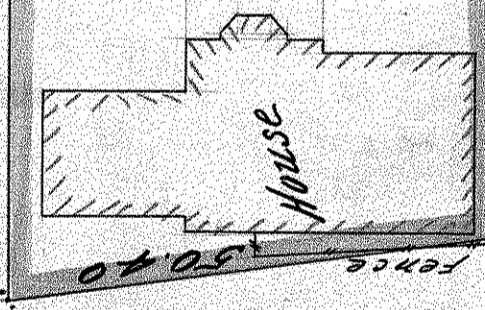

173.5

3 nails in Walk

50.00

166.70

stake

stake

Fence

House