


LINE BET. E. 1/2 & W. 1/2 of W. 1/2 of S.W. 1/4 of
SEC. 1, T. 28, R. 22

□ indicates mont.

• " Stake

300 ft. = 1 in.

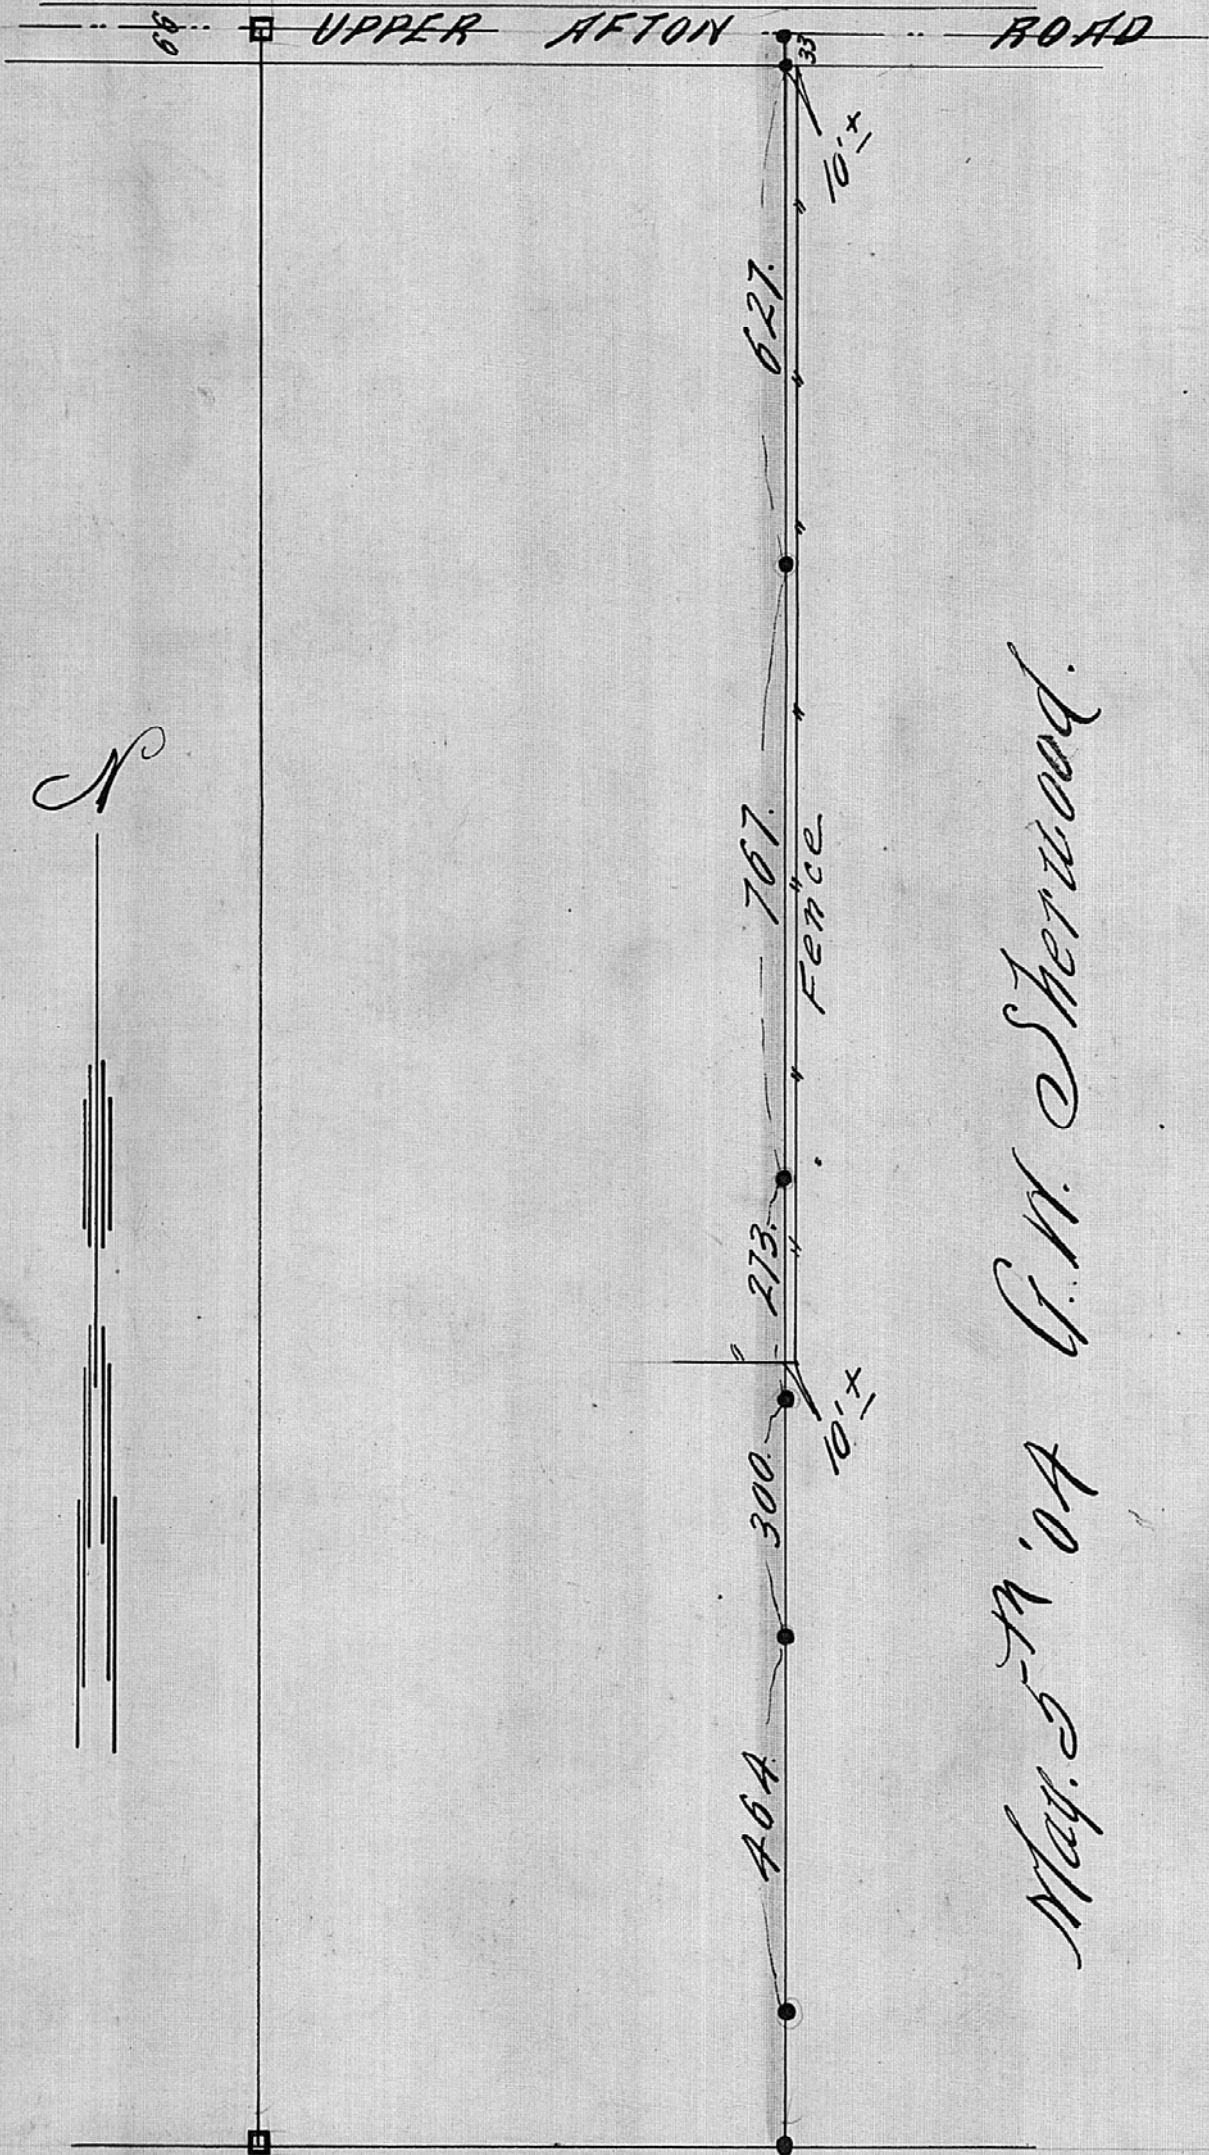

May. 5-19 '04 G. W. Sherwood.