


THE SLY. 34⁷/₈ RODS OF ELY. 140. OF S. 1/2 OF N.E. 1/4 OF
 SEC. 26, T. 30, R. 23.

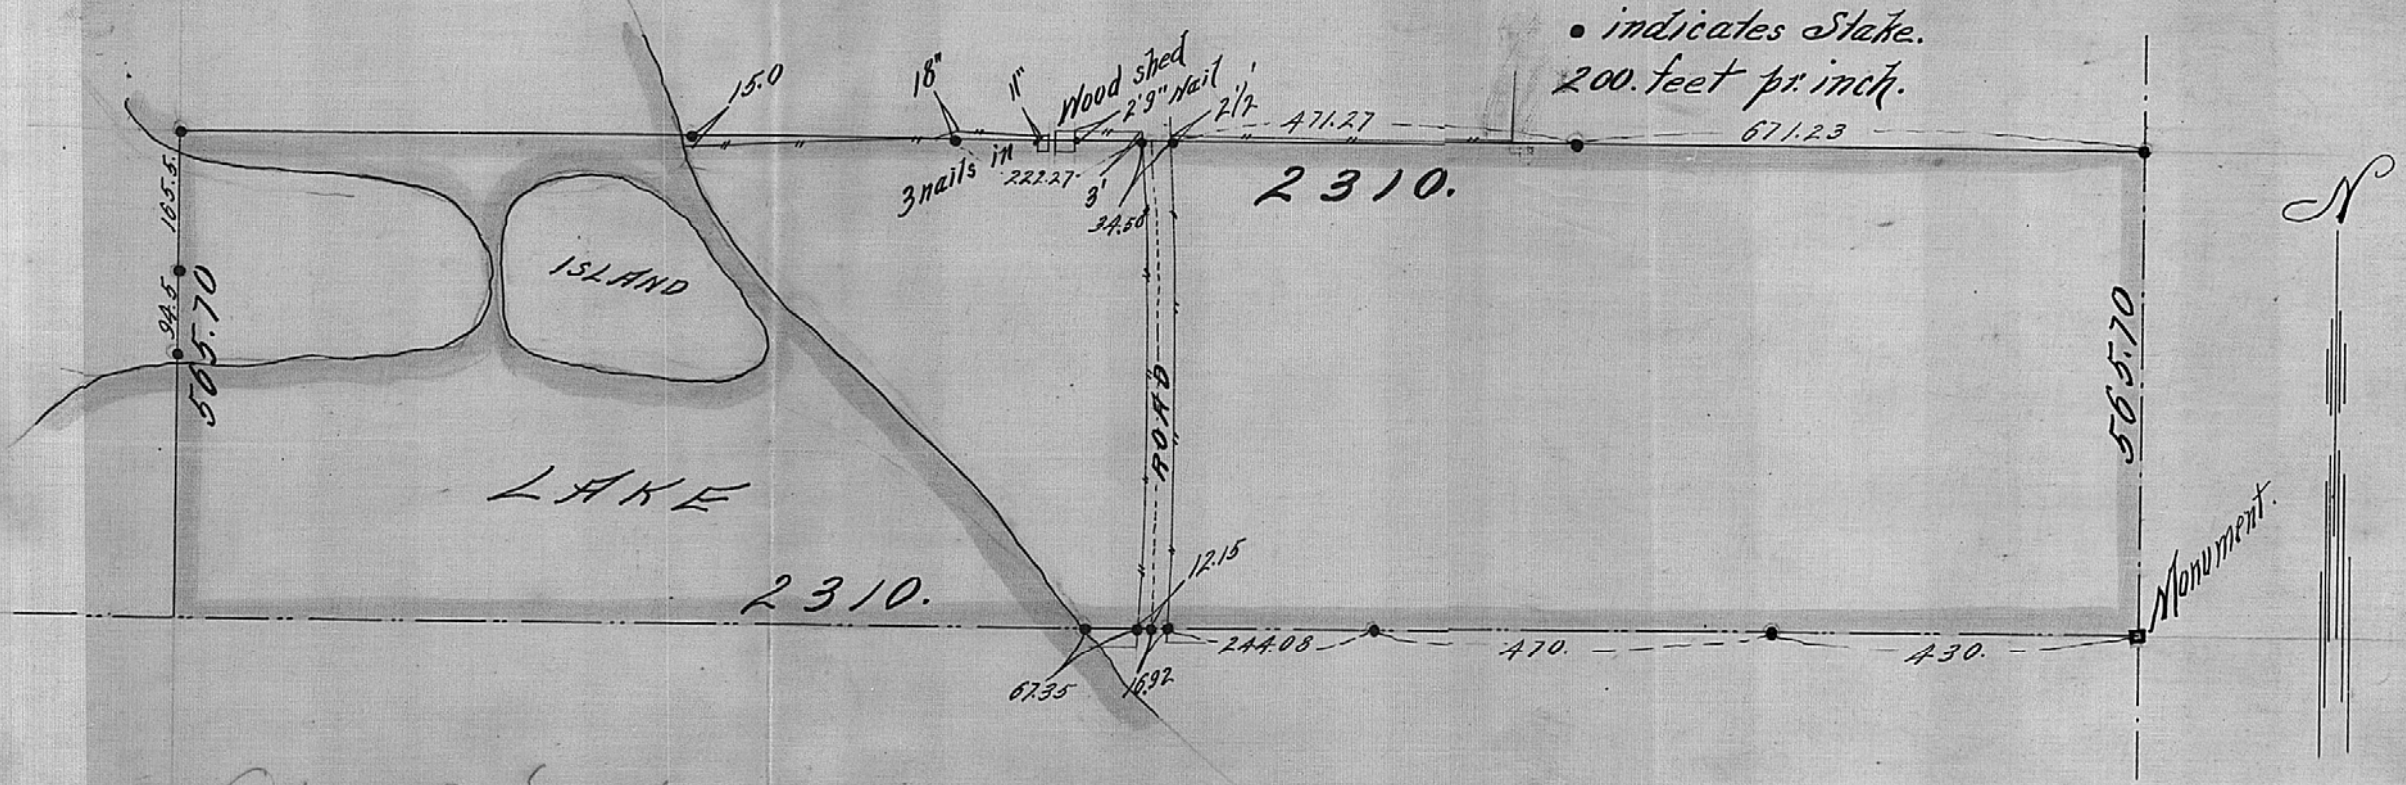

• indicates Stake.
 200 feet pr. inch.

Apr 9 '04