


LOTS 5 & 6 BLOCK 12
BREWSTER'S ADD.

Scale 20 feet pr. inch
AVE.

COMO

SEPT. 04
CAPITOL BOULEVARD.

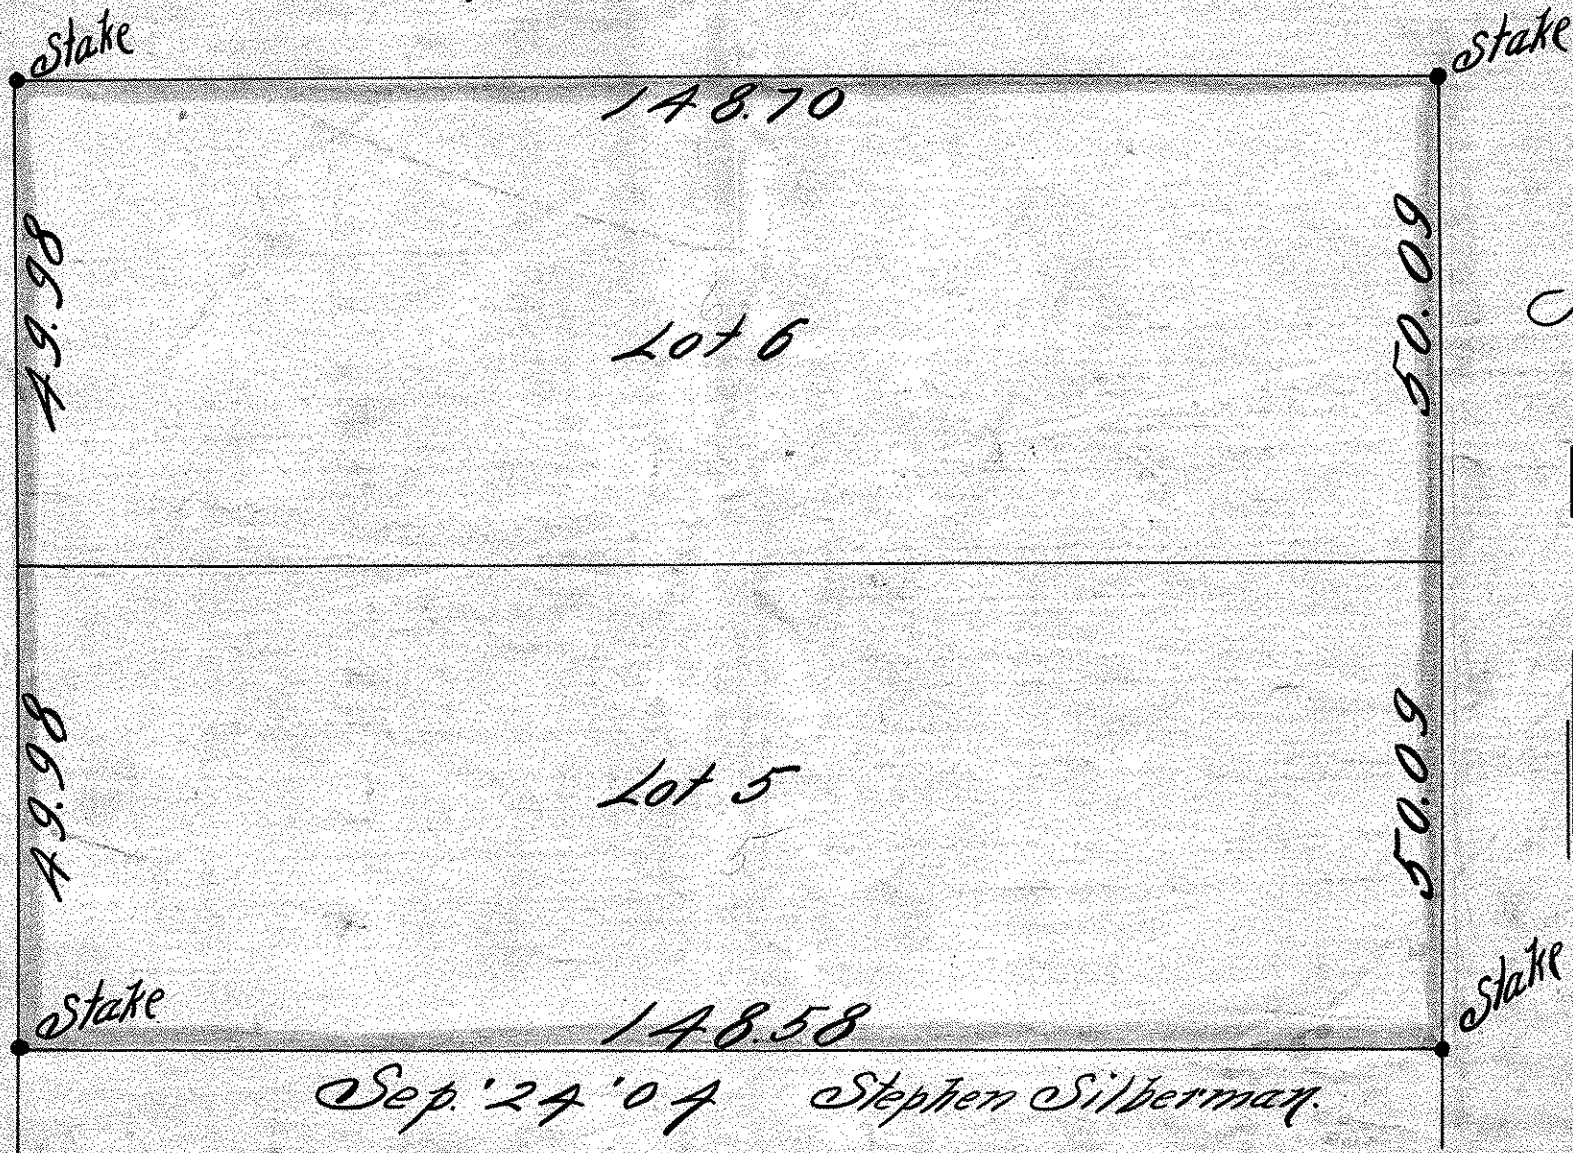

Sep. '24 '04 Stephen Silberman.