


Section A-B

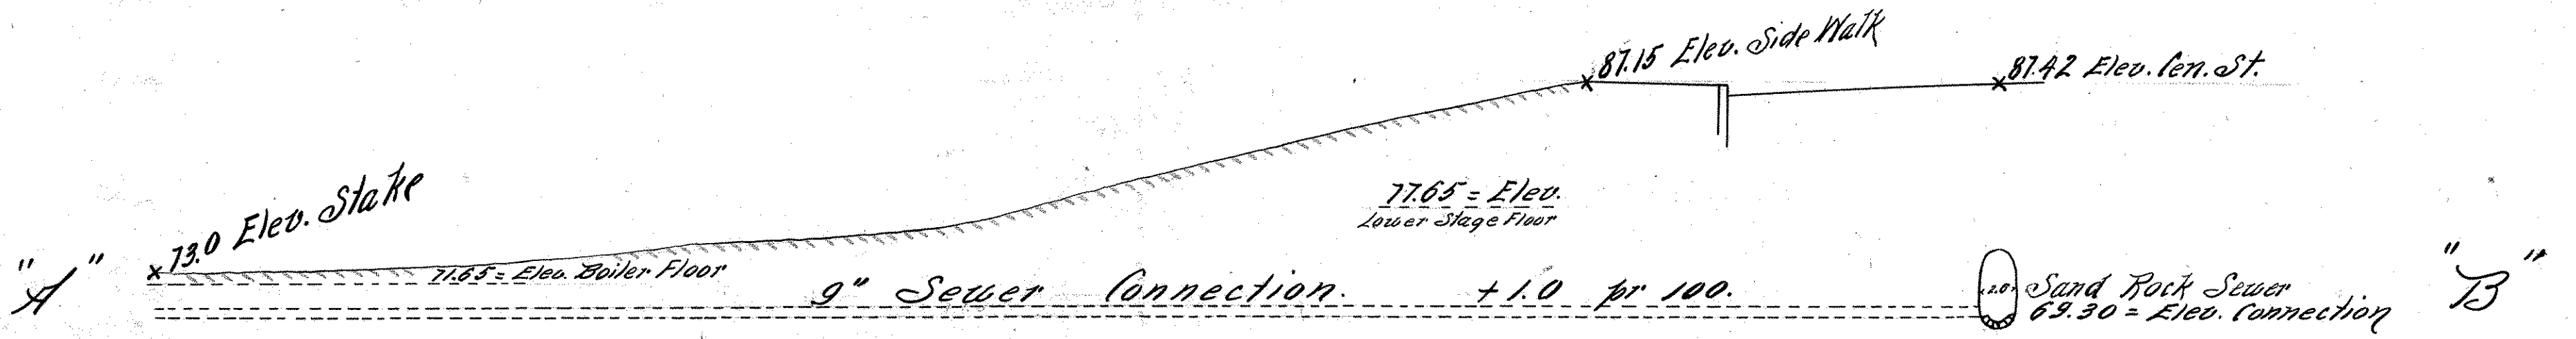

LOTS 1 AND 2 BLOCK 14
ROBERTS AND RANDALL'S ADD'N.

Scale 10 FEET per INCH

□ indicates Stake
○ indicates Hole in Walk.

• SURVEYED FOR CRITERION THEATRE CO.

OST

"I hereby certify that this diagram correctly represents
LOTS 1 & 2 BLOCK 14 ROBERTS & RANDALL'S ADD'N.
as surveyed by me April 29th 1904"

OST Paul Mann May 2nd 1904

John B. Swaine
County Surveyor from 16 Court House

ROBERT

ST.