


PART OF LOT 4 BLOCK 14 ROBERT & RANDALL'S ADD.

Scale 10 Feet pr. inch.

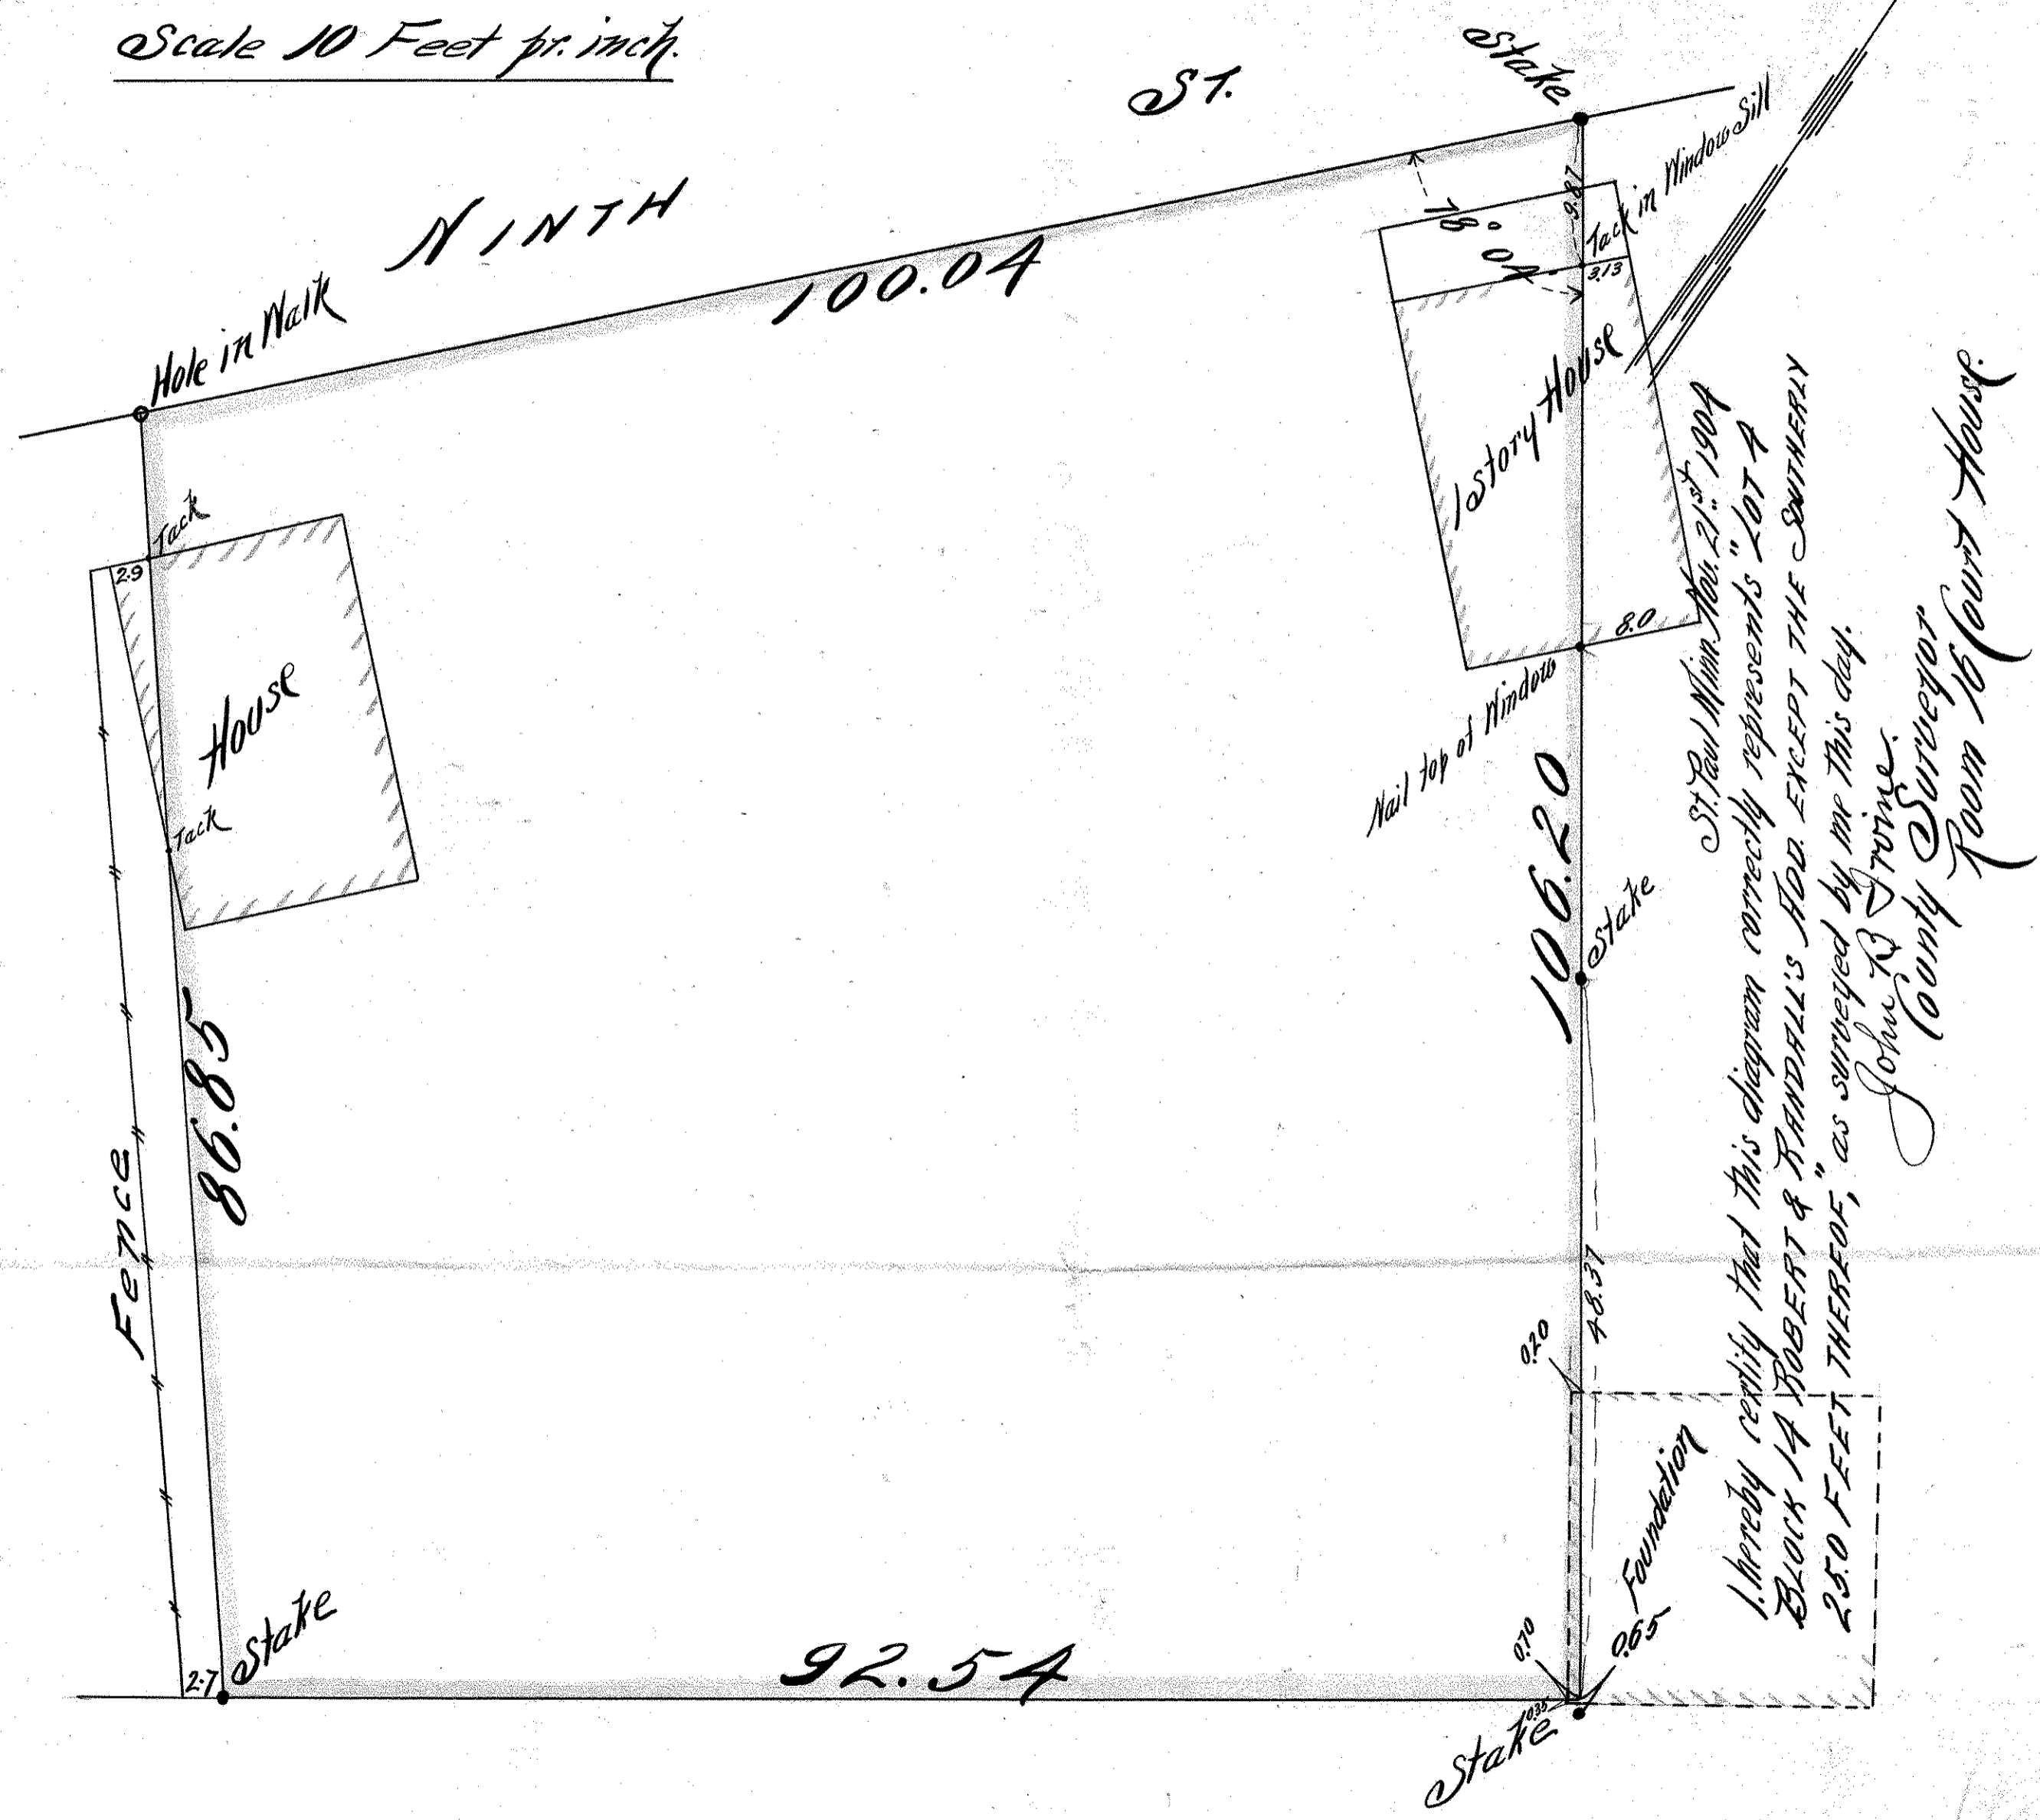

St. Paul Minn Nov. 21st 1904
 I hereby certify that this diagram correctly represents "LOT 4
 BLOCK 14 ROBERT & RANDALL'S ADD. EXCEPT THE SOUTHERLY
 25.0 FEET THEREOF," as surveyed by me this day.
 John B. Irvine
 County Surveyor Room 16 Court House.