


PART OF LOTS 3, 11 & 12 BLK. 14 ROBERT & RANDALL'S ADDITION.

Scale 10 Feet per inch



St Paul Minn. Nov. 21 '04
 I hereby certify that this diagram correctly represents Lots 3, 11 & 12 BLK 14
 ROBERT & RANDALL'S ADD. EXCEPT THE WESTERLY 50.85 FT. THEREOF, as
 surveyed by me this day.
 John B. Swine
 County Surveyor, Room 16 Court House.

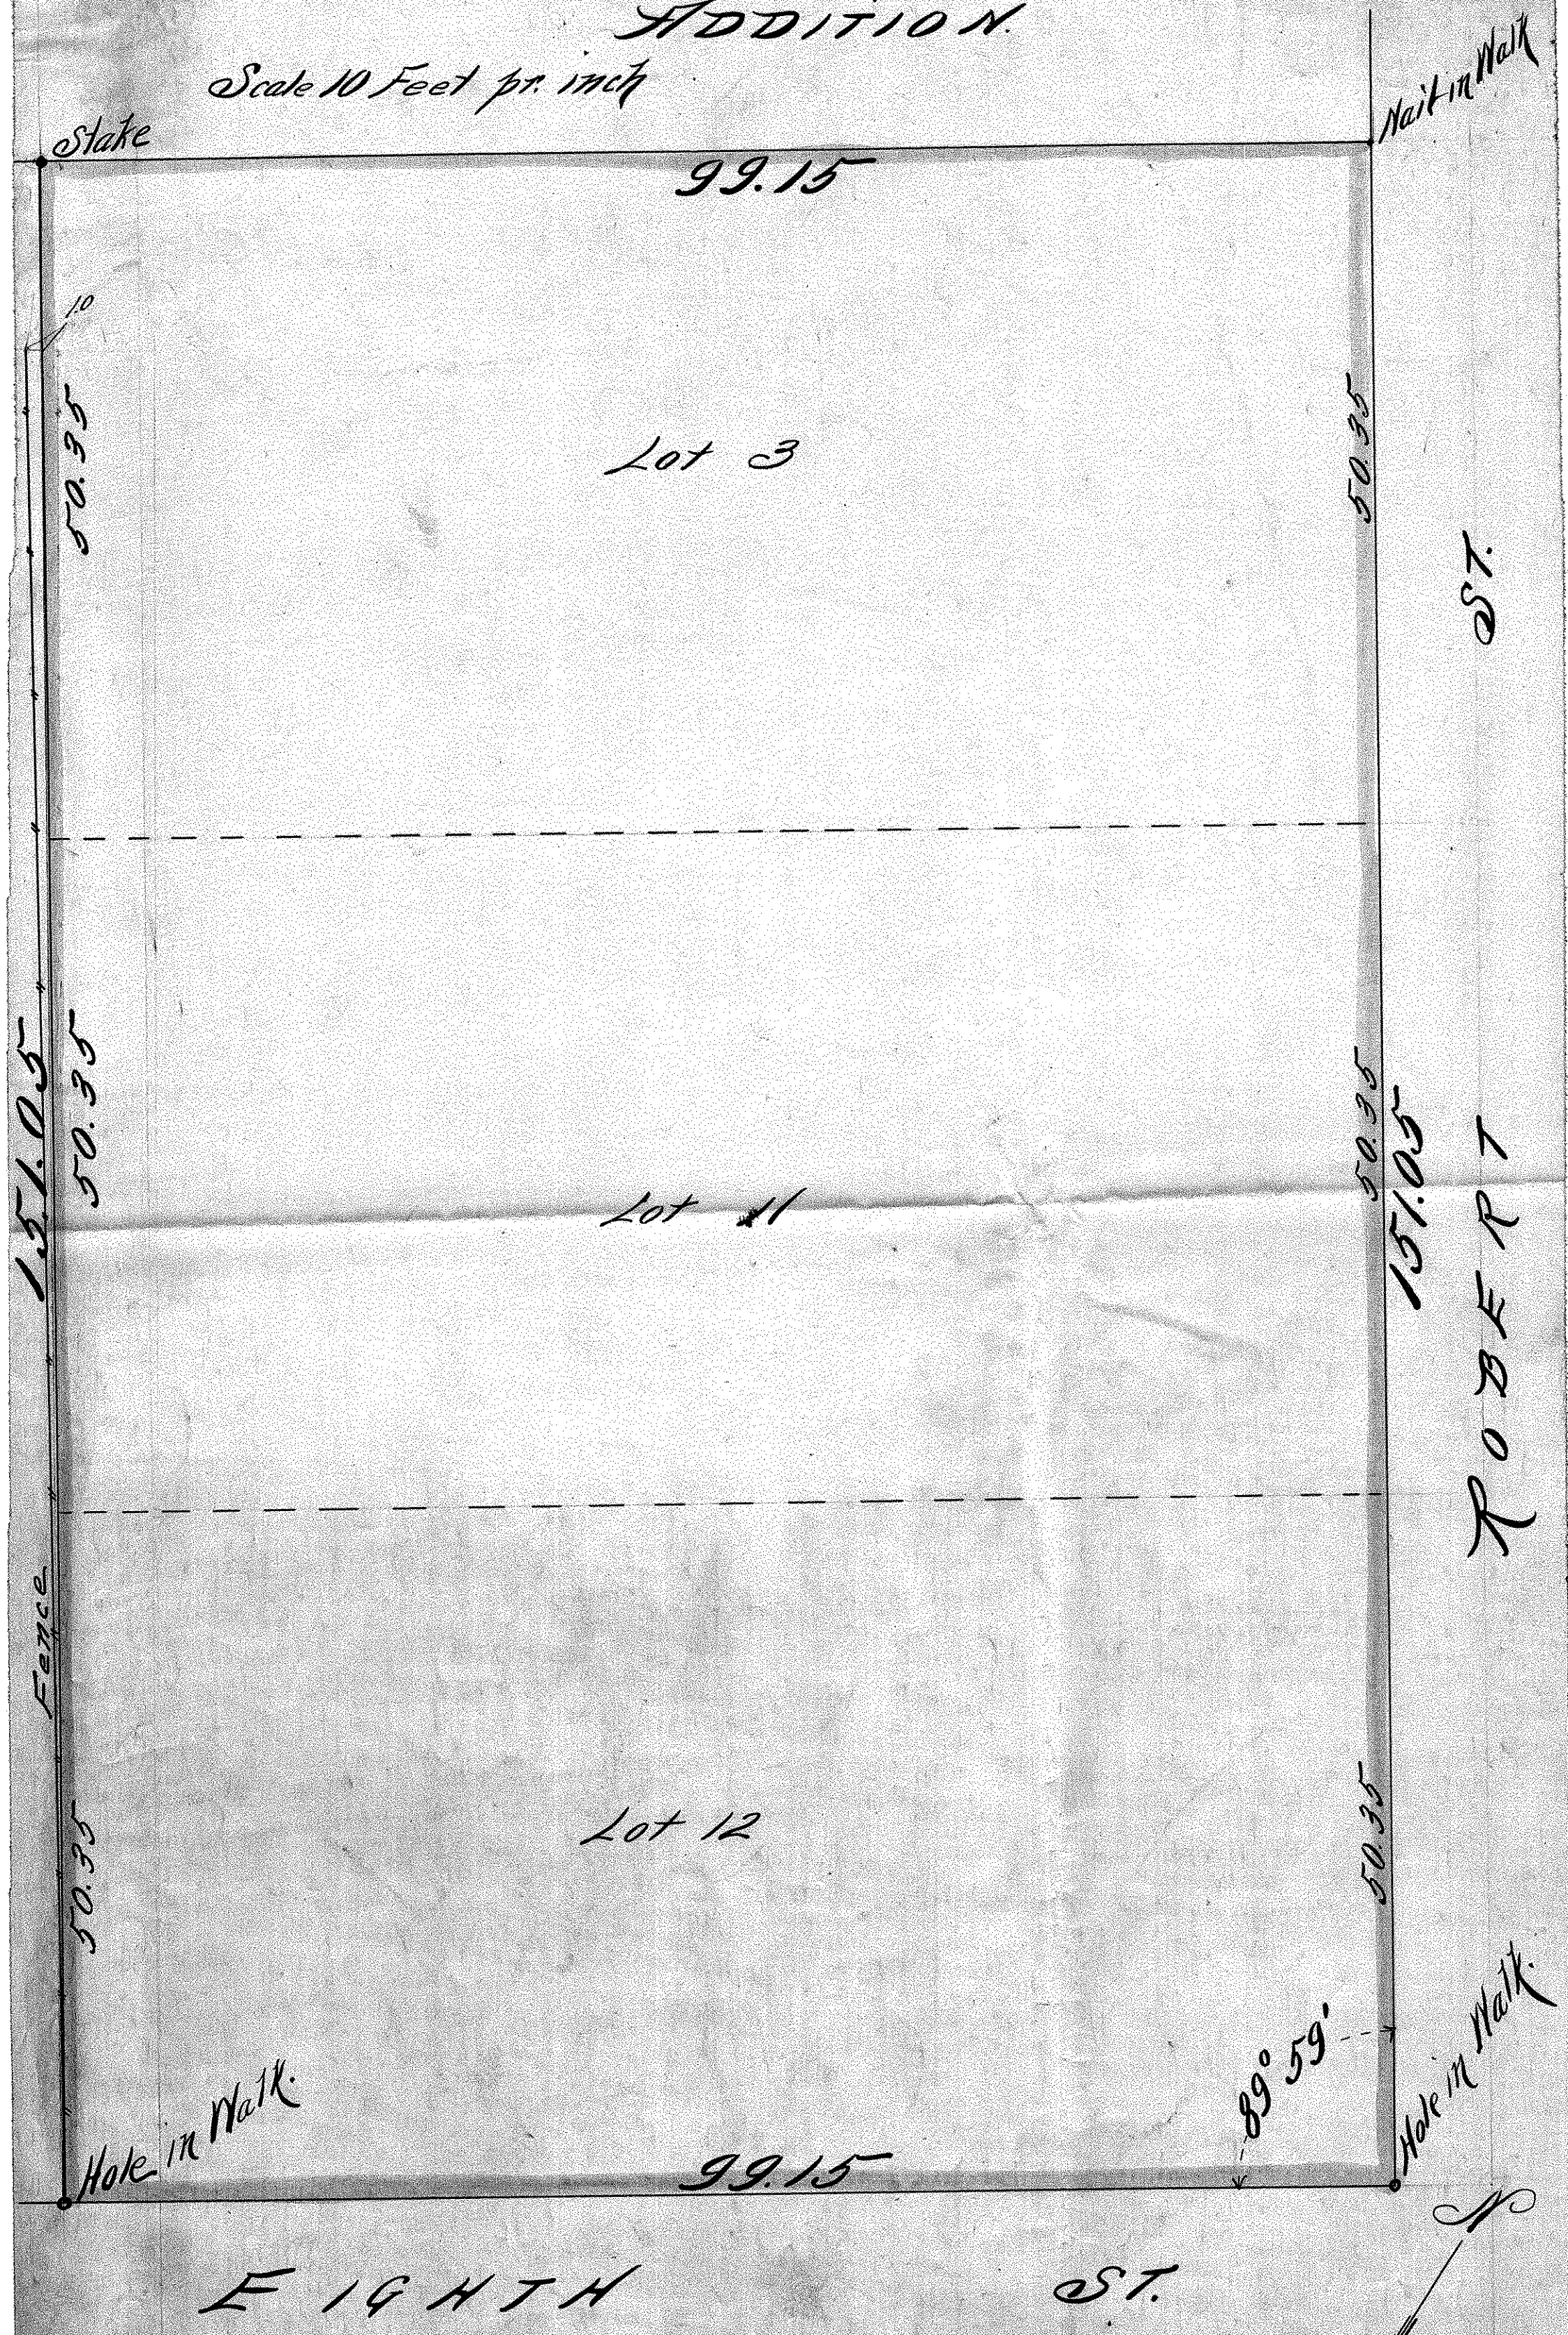