A MISC'L TRACT IN THE
W½ OF S.E.¼, 14.29.22

200' = 1" ∘ Iron • State

Zada Judd.
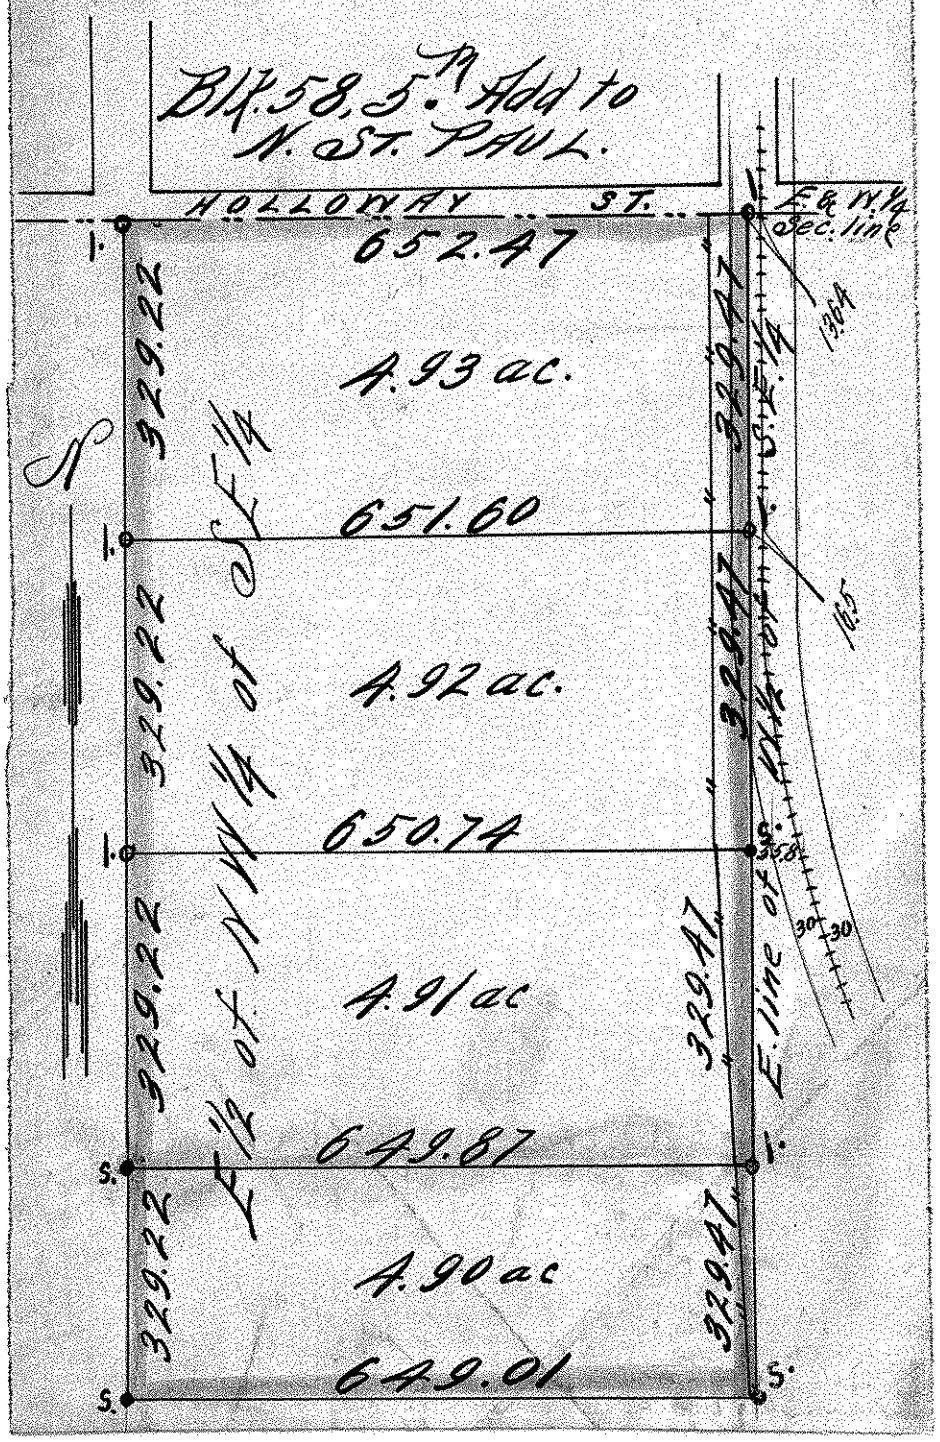
Nov. 26th 1904.