
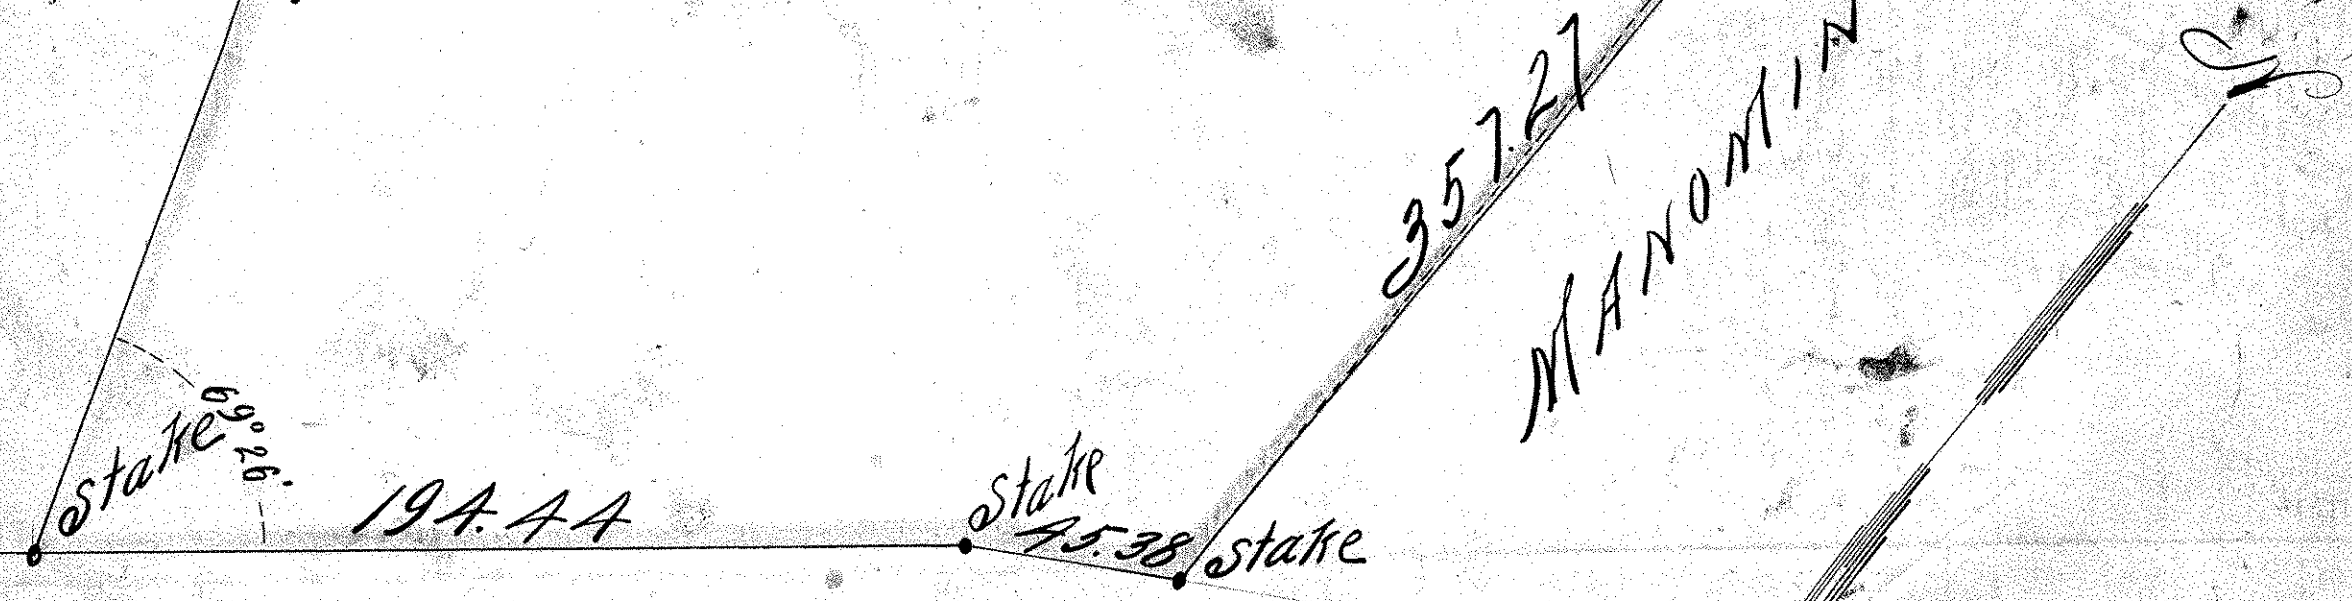
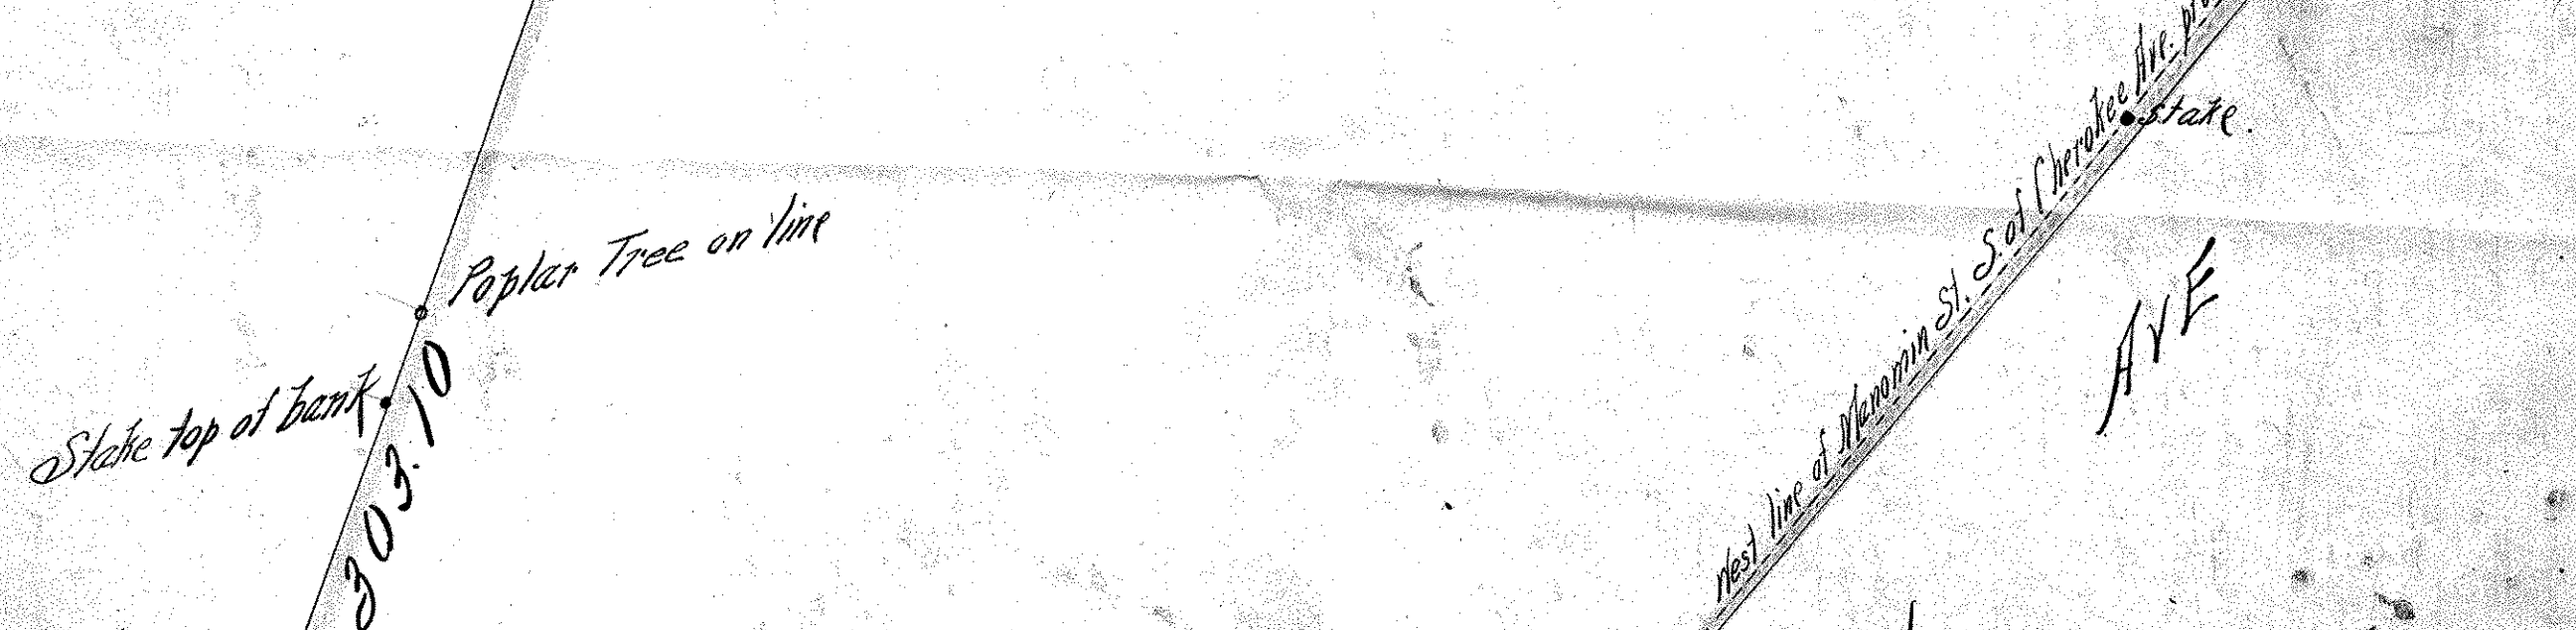
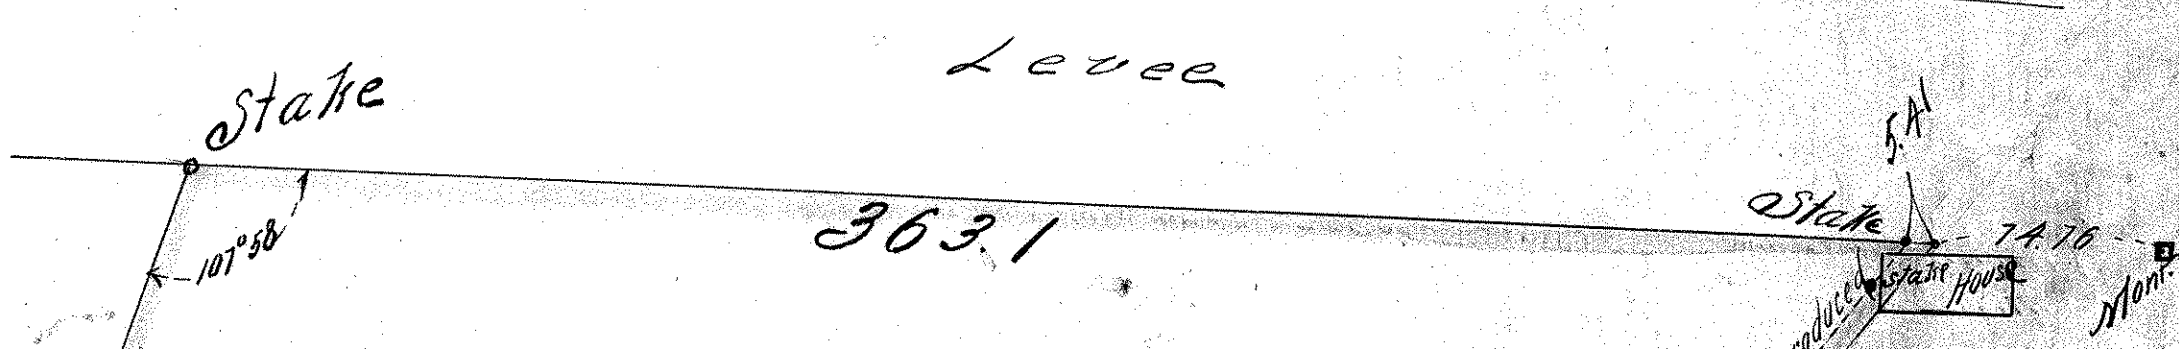


Lot "D" BANNING & OLIVER'S ADD. EXCEPT THE
W. 146 FEET. Scale 40 feet pr. inch
JUN 4 1904 Nets J. Ness

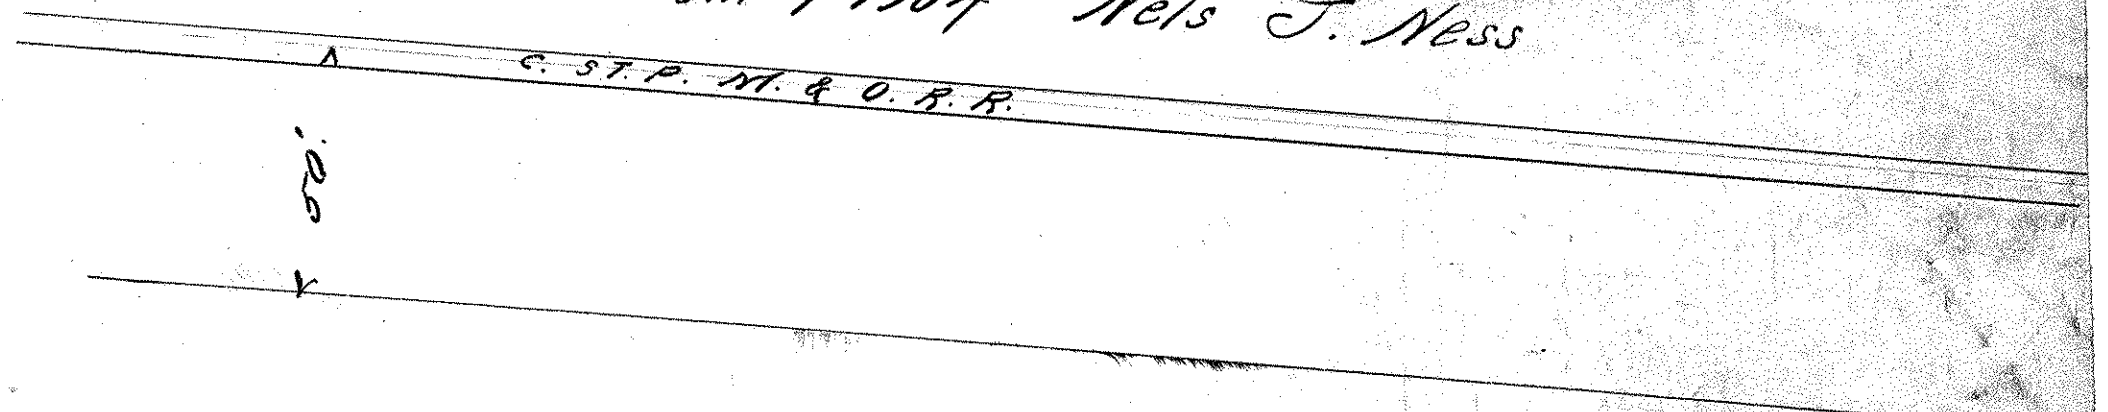

CHEROKEE AVE.