


LOTS 9, 12, 13 & 14 Wm. M. BOLES REAR OF
BLK. 54 BANNING & OLIVERS.

• = stake
20' = 1"

May 17th 1904

ST.

OTTAWA

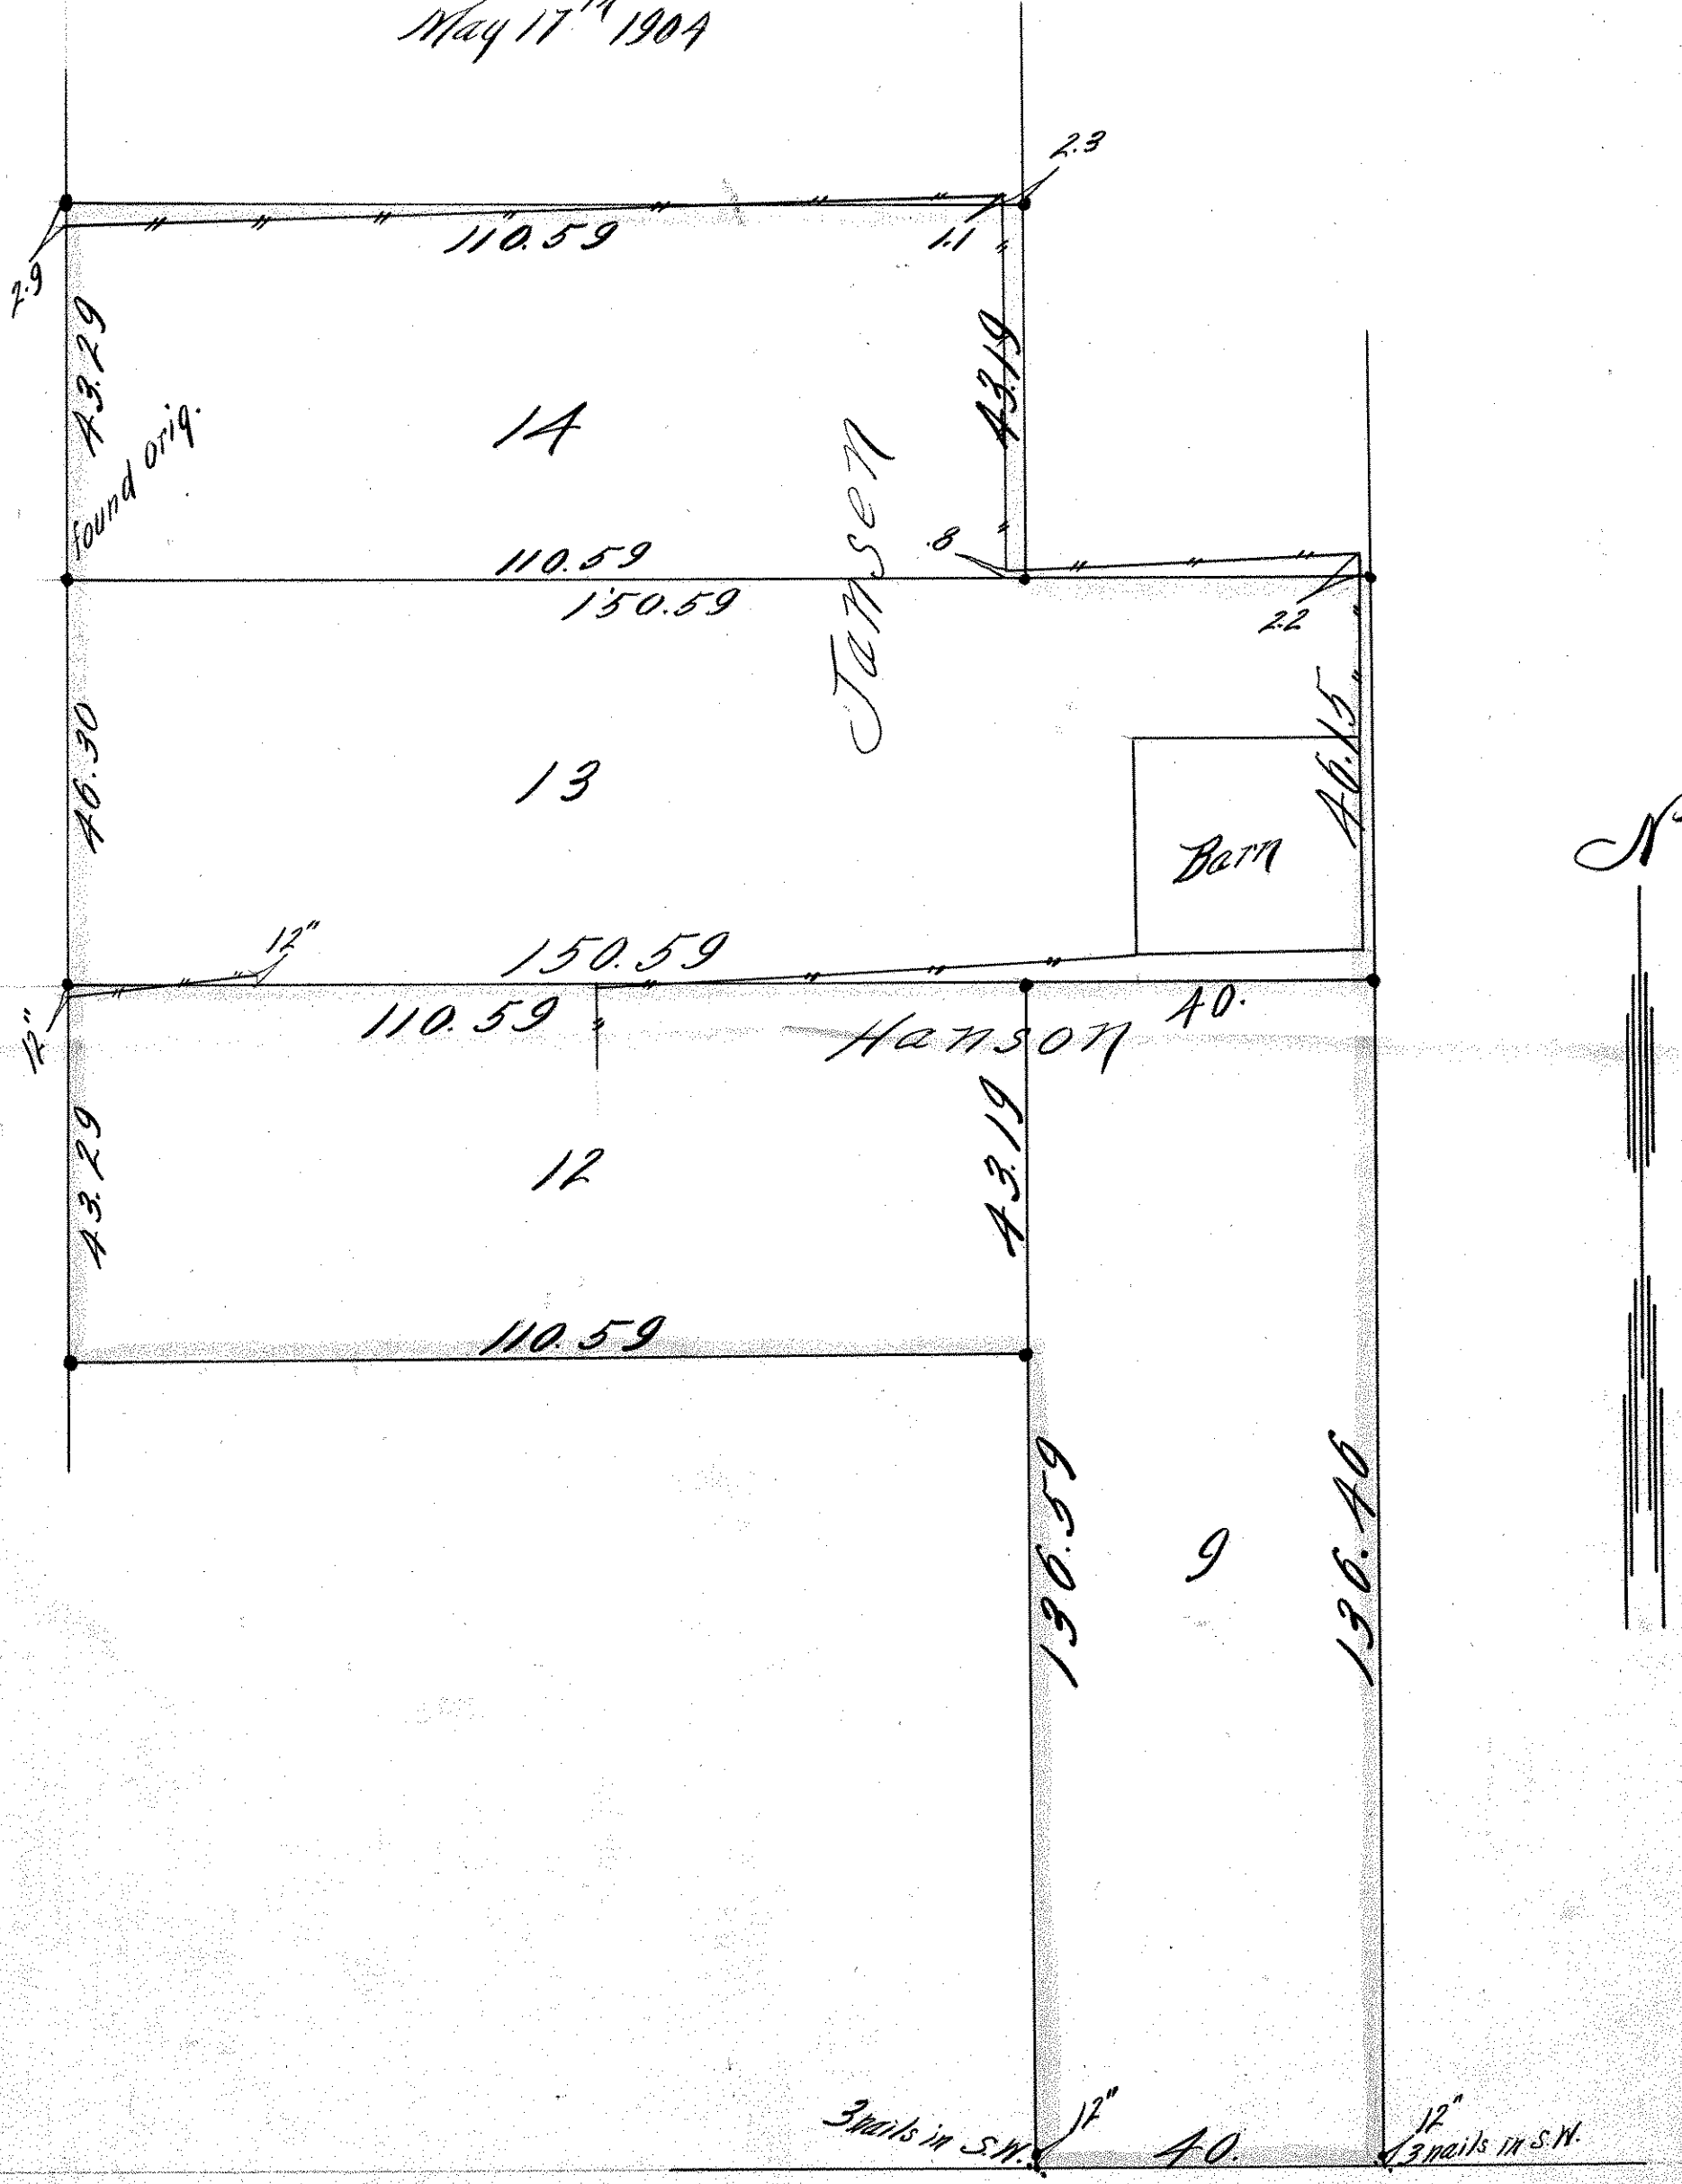

ANNAPOLIS ST.