


OTTAWA ST.

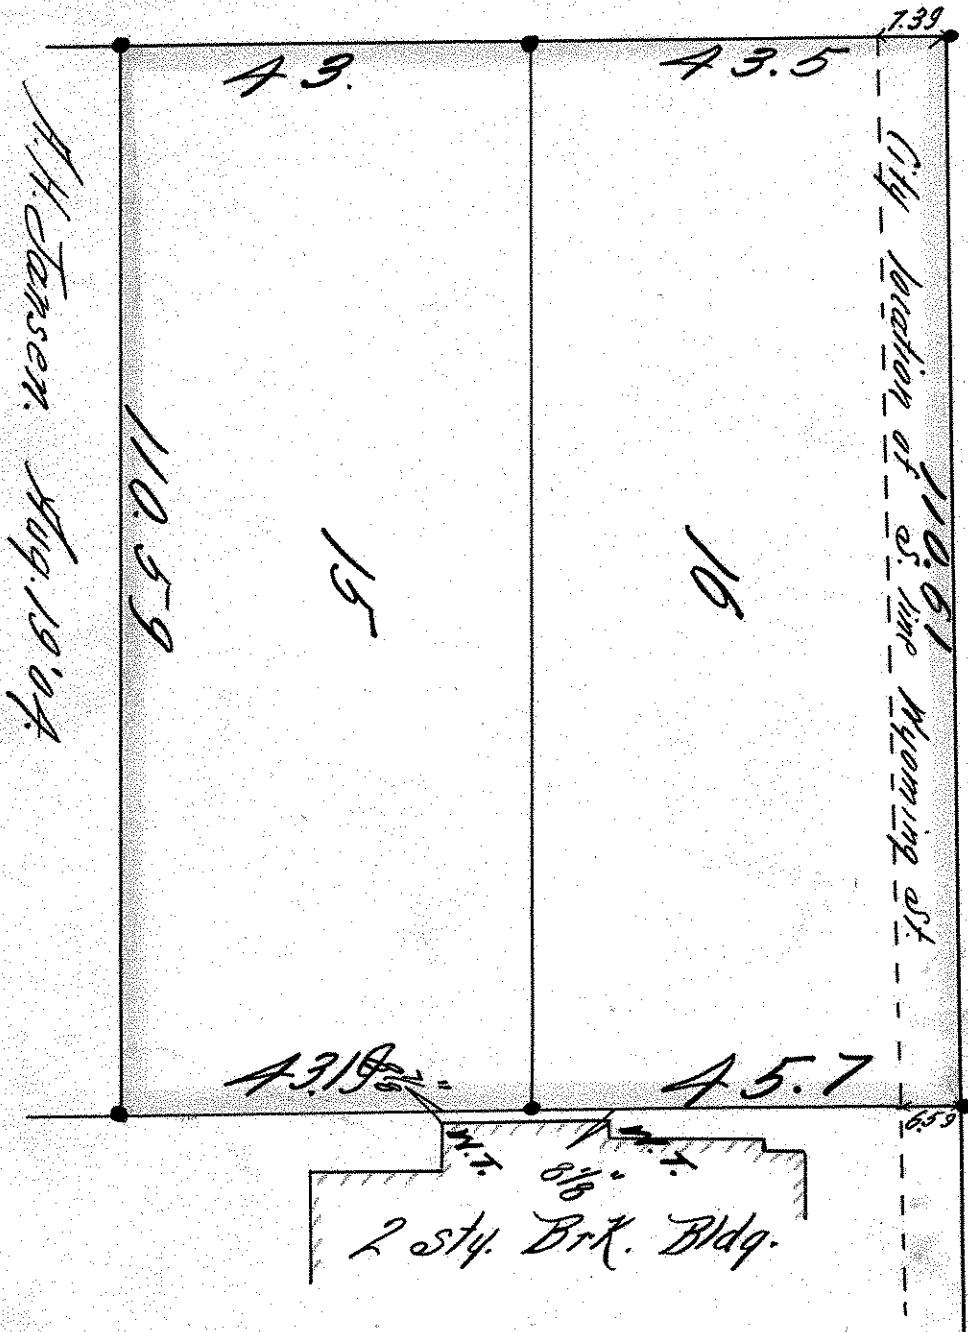

A.H. Jensen. Aug. 1904

20' = 1" = State

WYOMING ST.

LOTS 15 & 16 BATES REAR OF BAY ST

BANNING & OLIVER'S ADD.


45.7

110.61

15

16