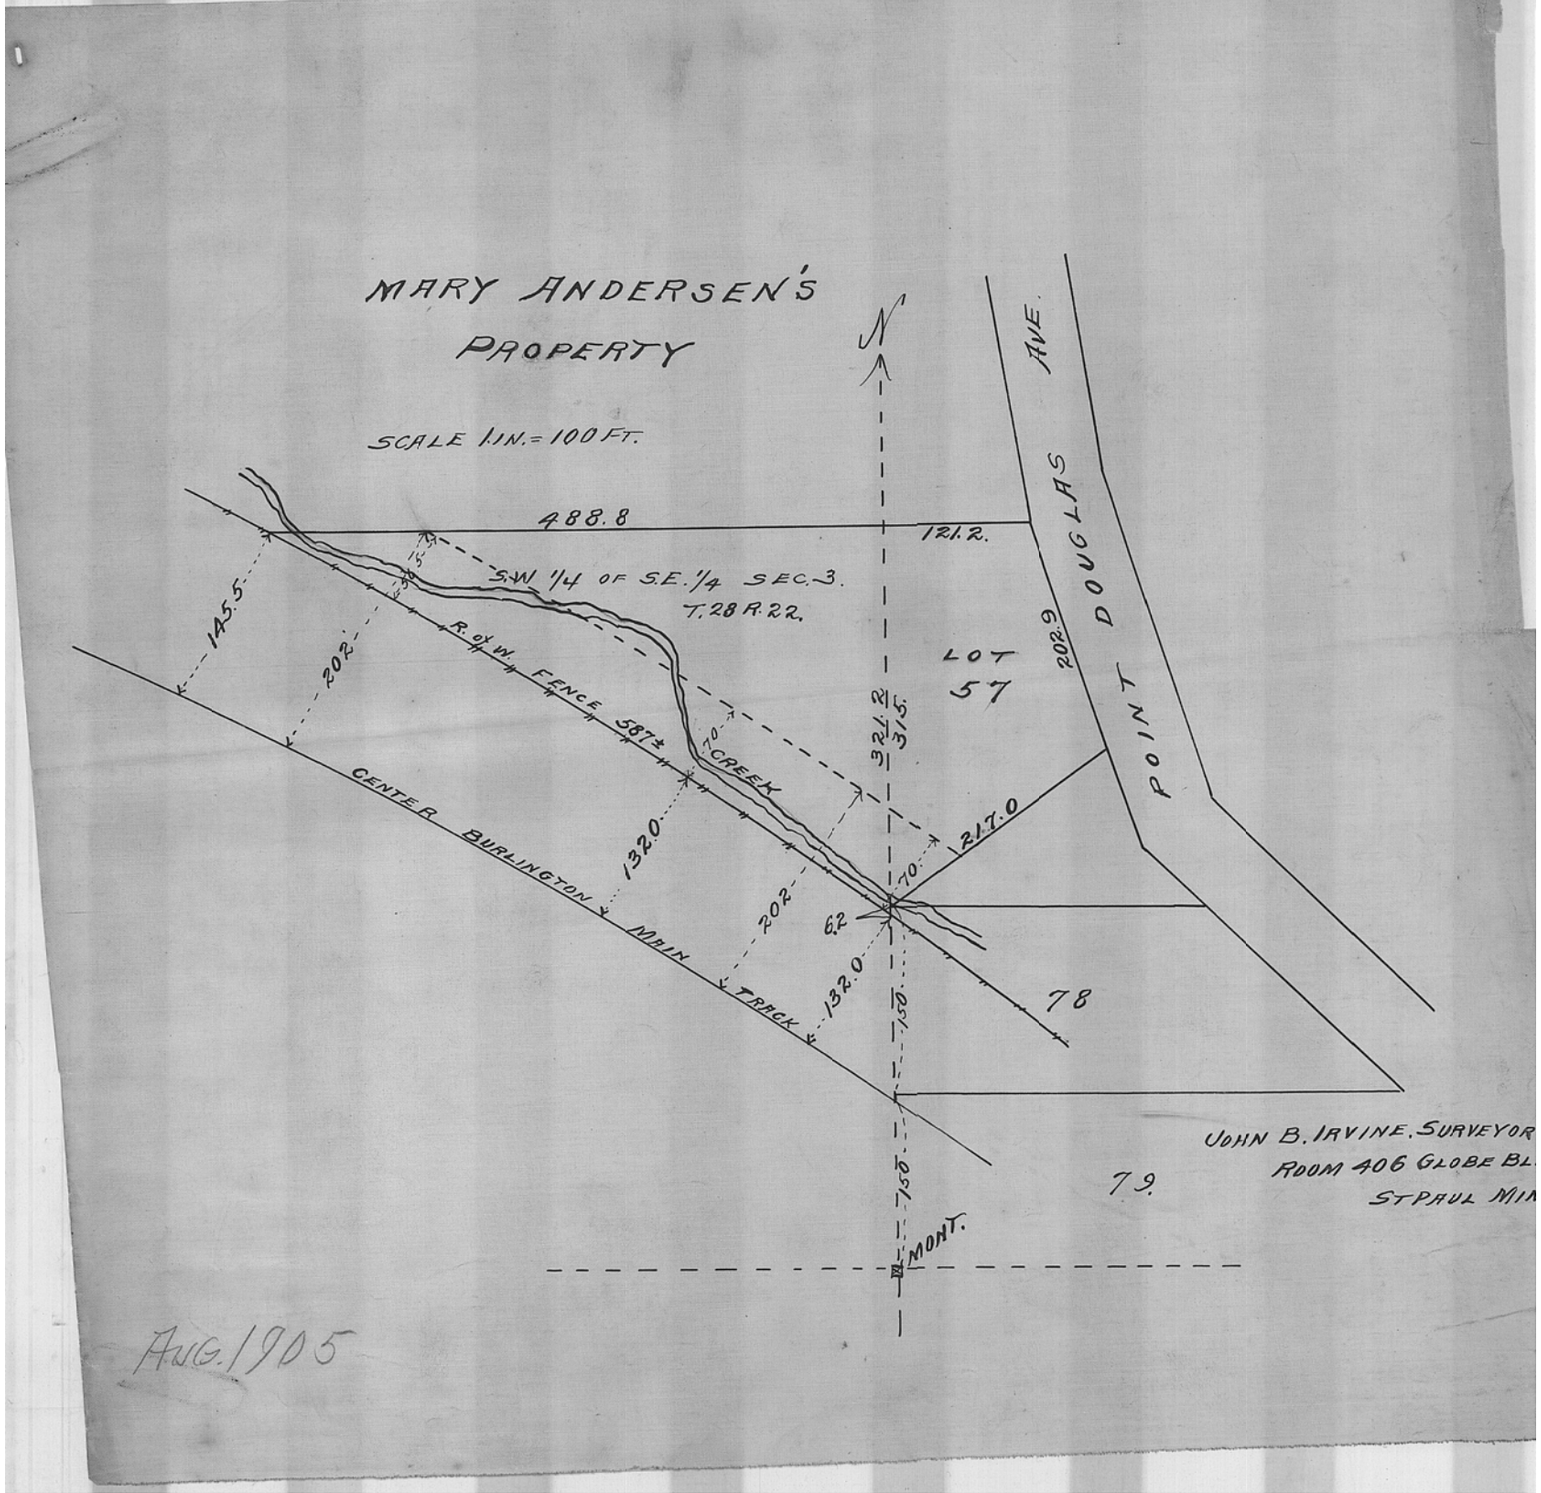
MARY ANDERSEN'S
PROPERTY
SCALE 1 IN. = 100 FT.
488.8
121.2
S.W 1/4 OF S.E. 1/4 SEC. 3.
T. 28 R. 22.
145.5
202'
R. of W. FENCE 587±
CREEK
CENTER BURLINGTON MAIN TRACK
1320
202'
6.2
1320
321.2
31.5
70
217.0
150
150
MONT.
LOT
57
78
79
202.9
DOUGLAS
POINT
AVE.
JOHN B. IRVINE. SURVEYOR
ROOM 406 GLOBE BL.
ST PAUL MIN
AUG. 1905