


MISCELLANEOUS TRACT IN
 LOT 2 SEC. 24, T. 30, R. 22.

□ INDICATES STAKES

SCALE 1 IN. = 50 FT.

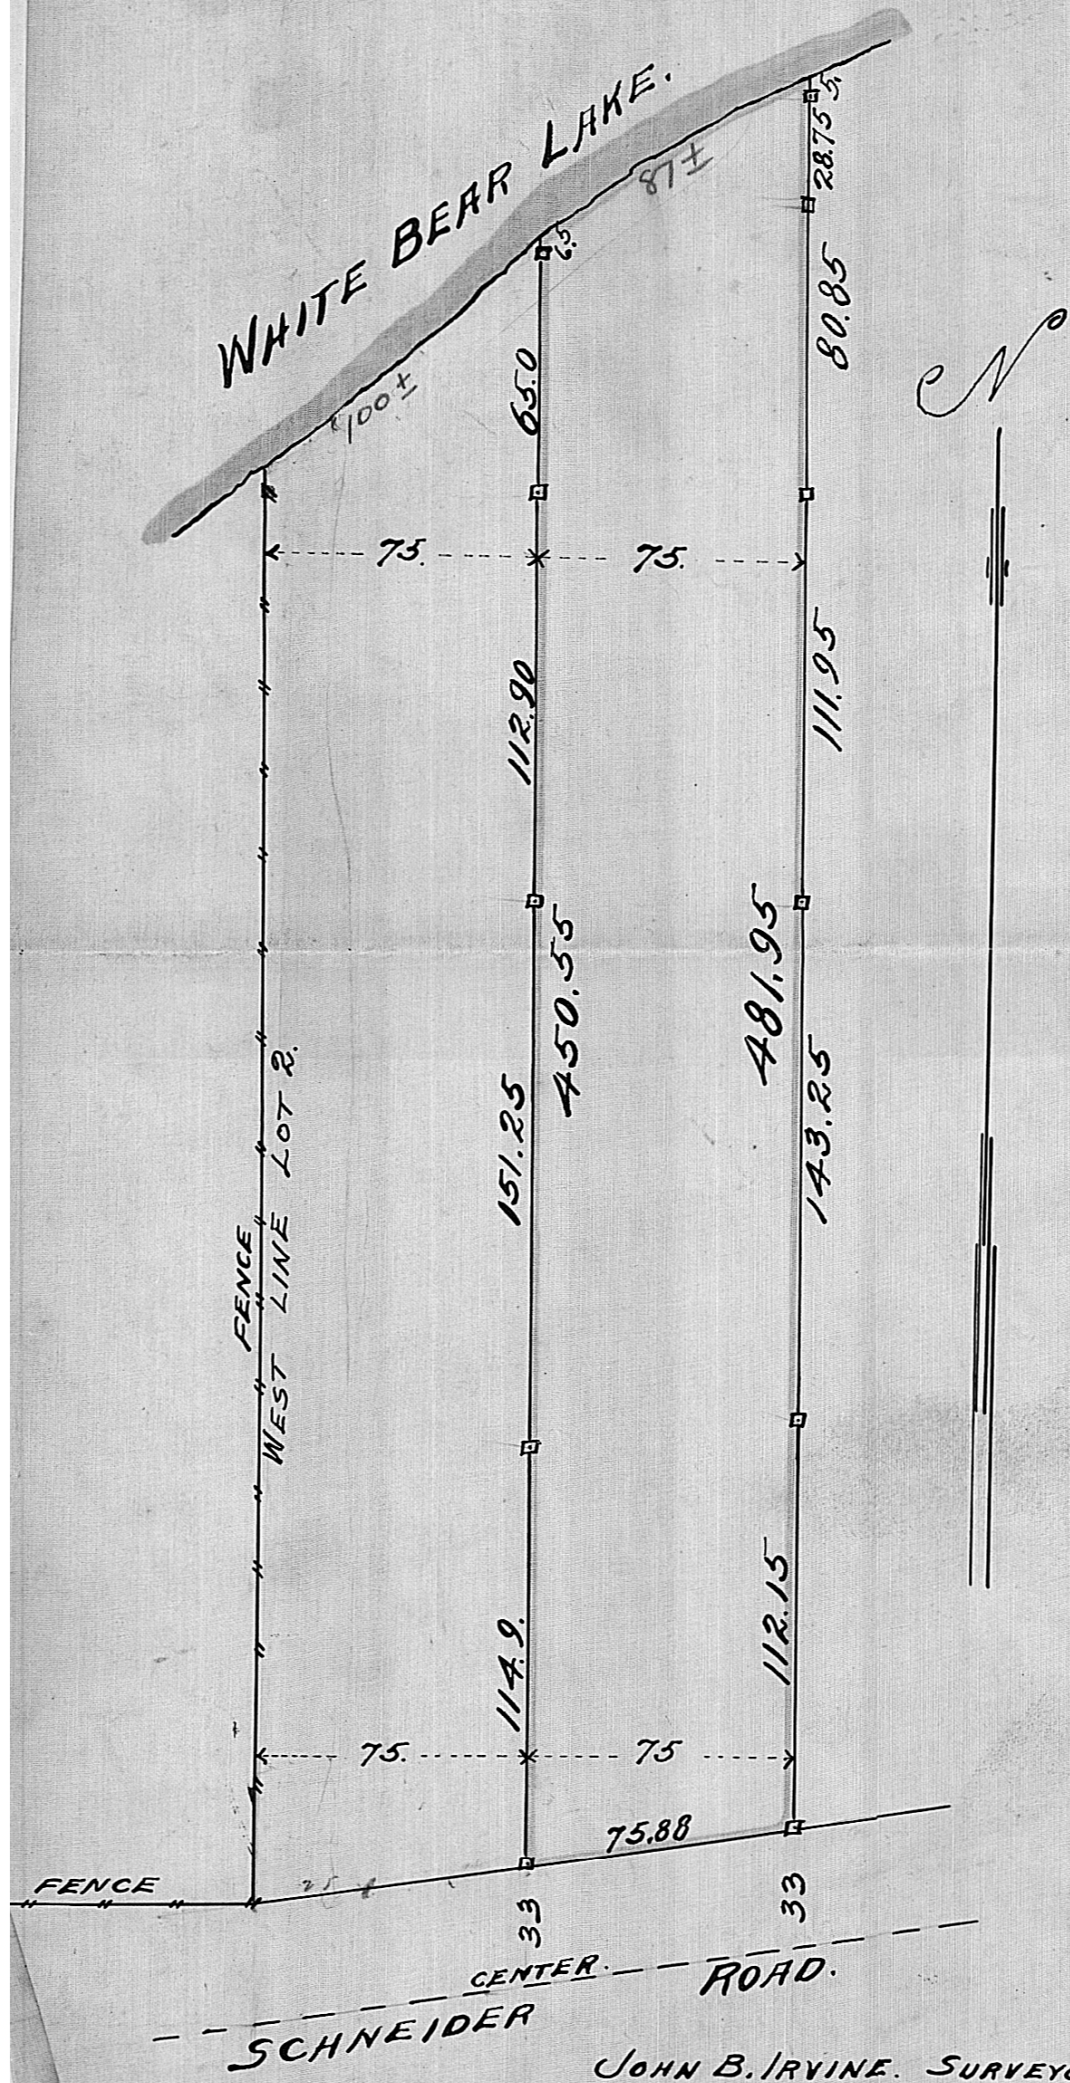

JOHN B. IRVINE. SURVEYOR.
 ROOM 508 GLOBE BLDG
 ST. PAUL MINN.
 JUNE 29-05.