EAST ½ of N.E.¼ & S.W.¼ of N.E.¼ LESS R.R.
SEC. 34. T. 30. R. 22.

JOHN B. IRVINE. SURVEYOR.
ROOM 508 GLOBE BLD'G
ST PAUL. MINN.
JUNE 14-05.
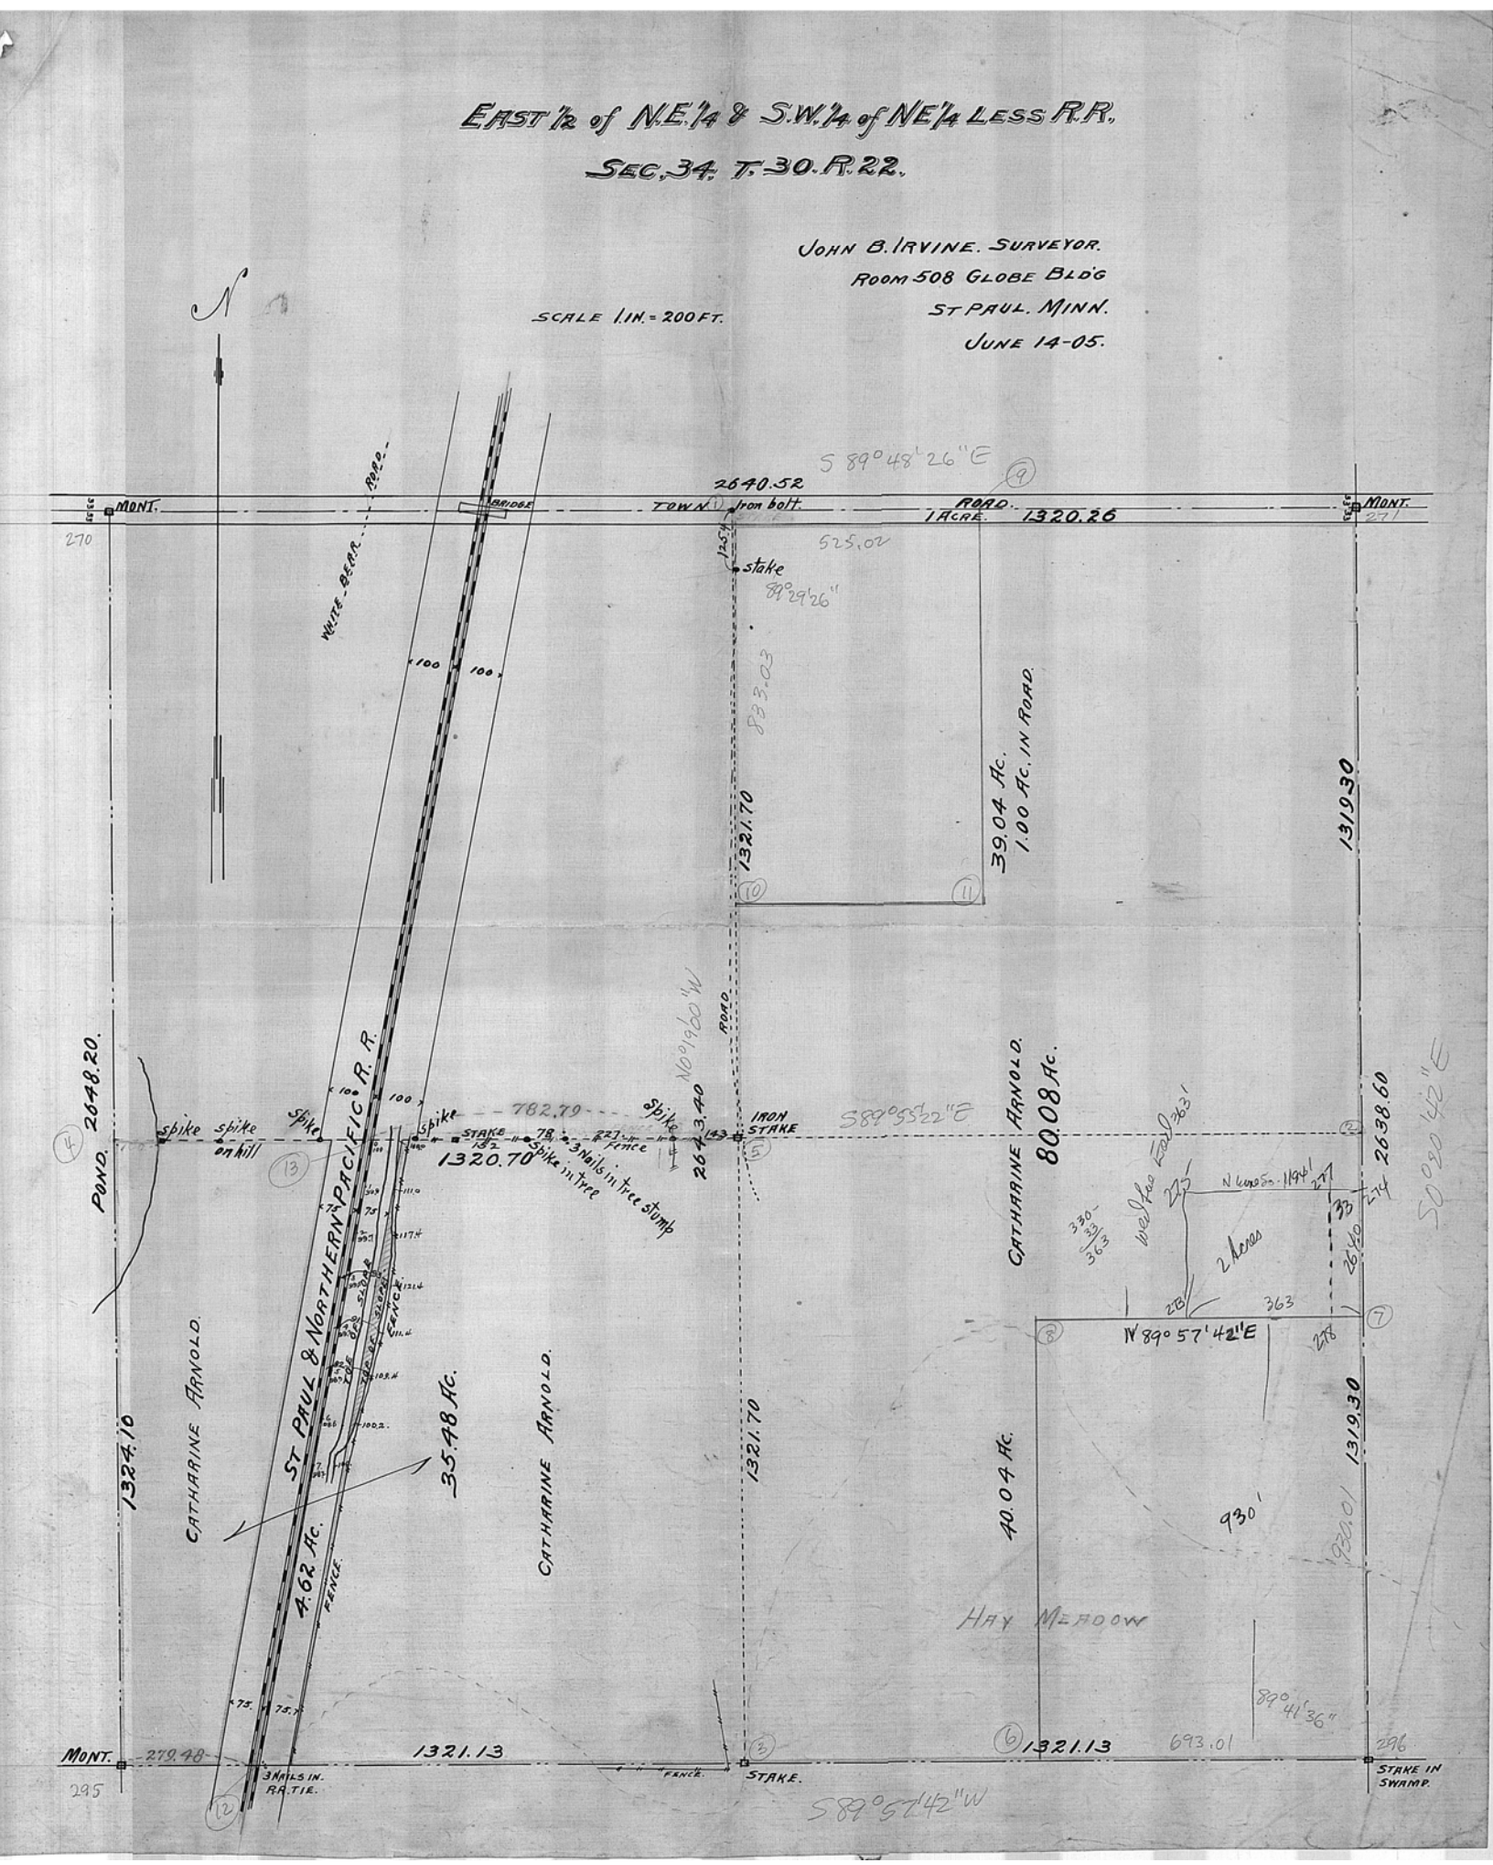
SCALE 1 IN. = 200 FT.