LOTS 10 & 11 EXCEPT EAST 10FT. BLK 3

BREWSTER'S ADDITION.

JOHN B. IRVINE SURVEYOR.

ROOM 406 GLOBE BLD'G.

ST PAUL MINN.
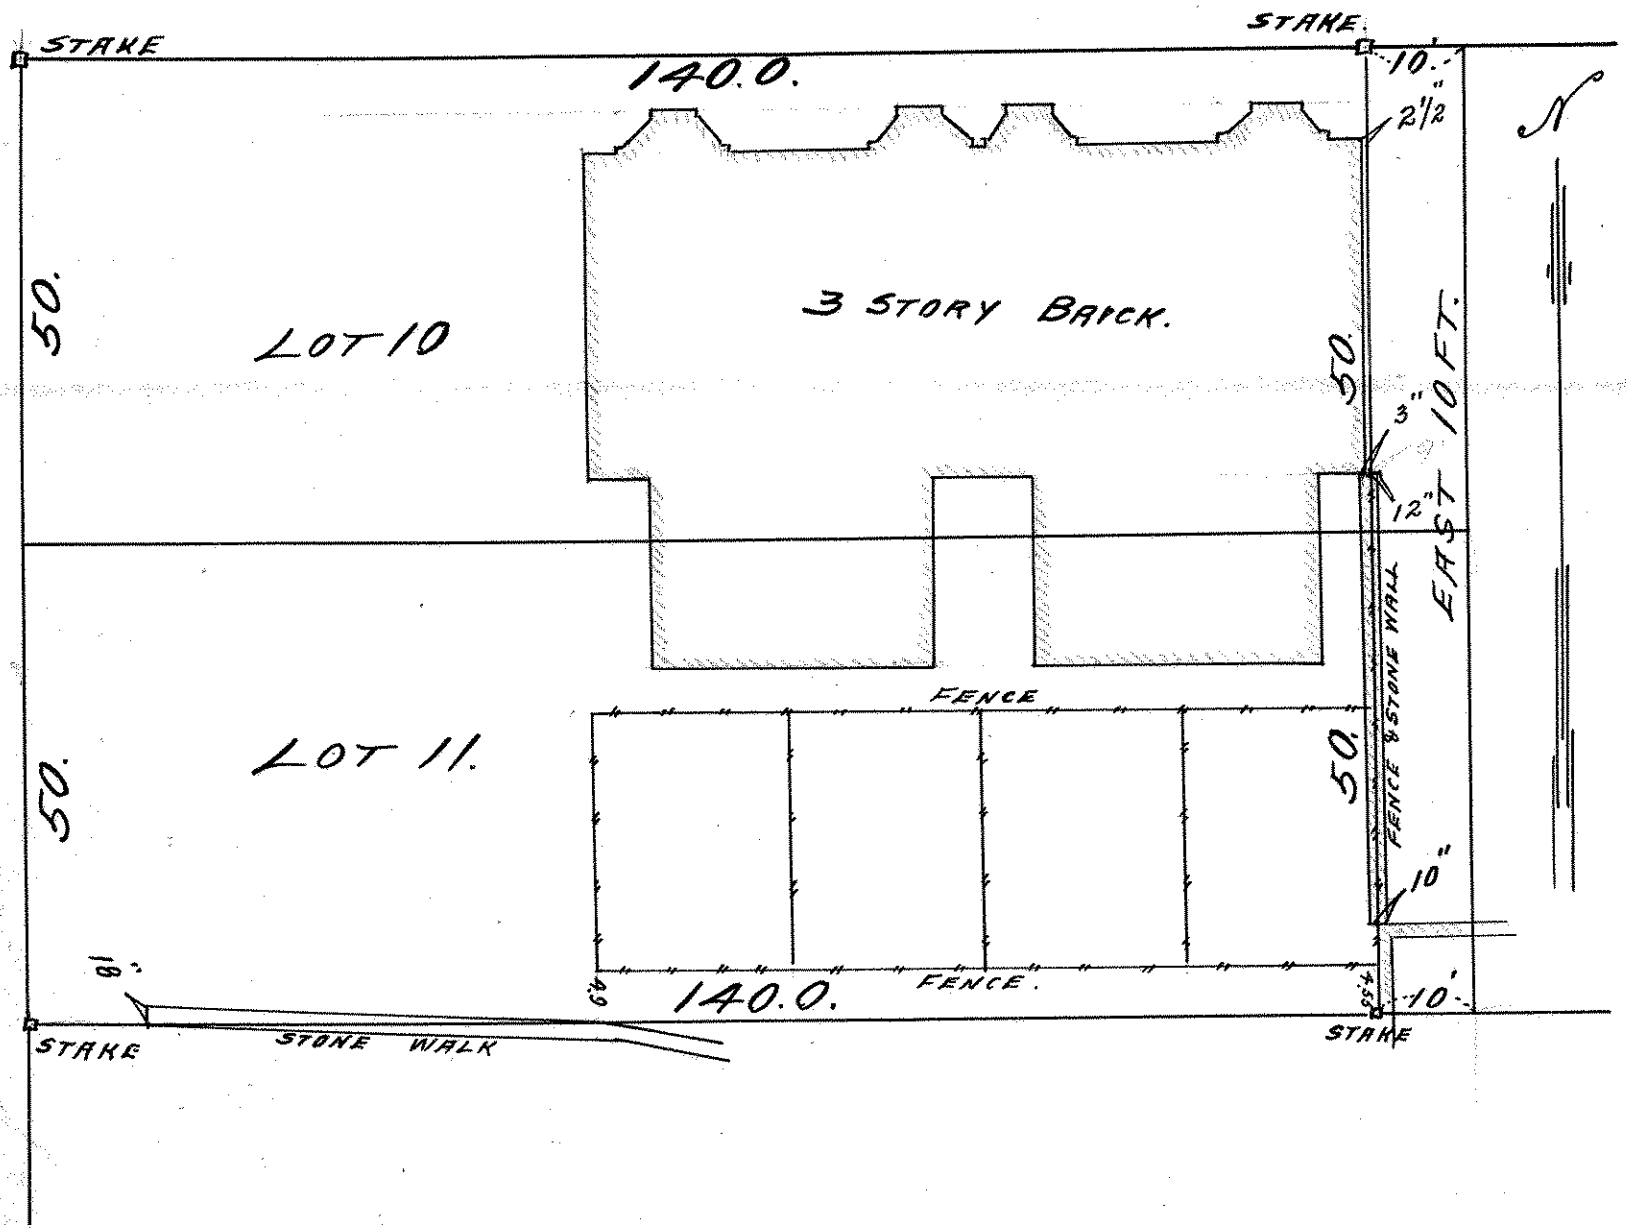
APRIL 18-06.