29 22

LOCATION OF SIDEWALK & RETAINING WALL ON SOUTH SIDE OF NINTH ST. BETWEEN CEDAR & MINNESOTA STREETS.

Blk 13 Robert + Randalls

JOHN. B. IRVINE. SURVEYOR.
ROOM 416 GLOBE BLD'G.
ST PAUL MINN.

JUNE 11-06

SCALE 1.IN.=20FT.

E. NINTH ST. PLAN.

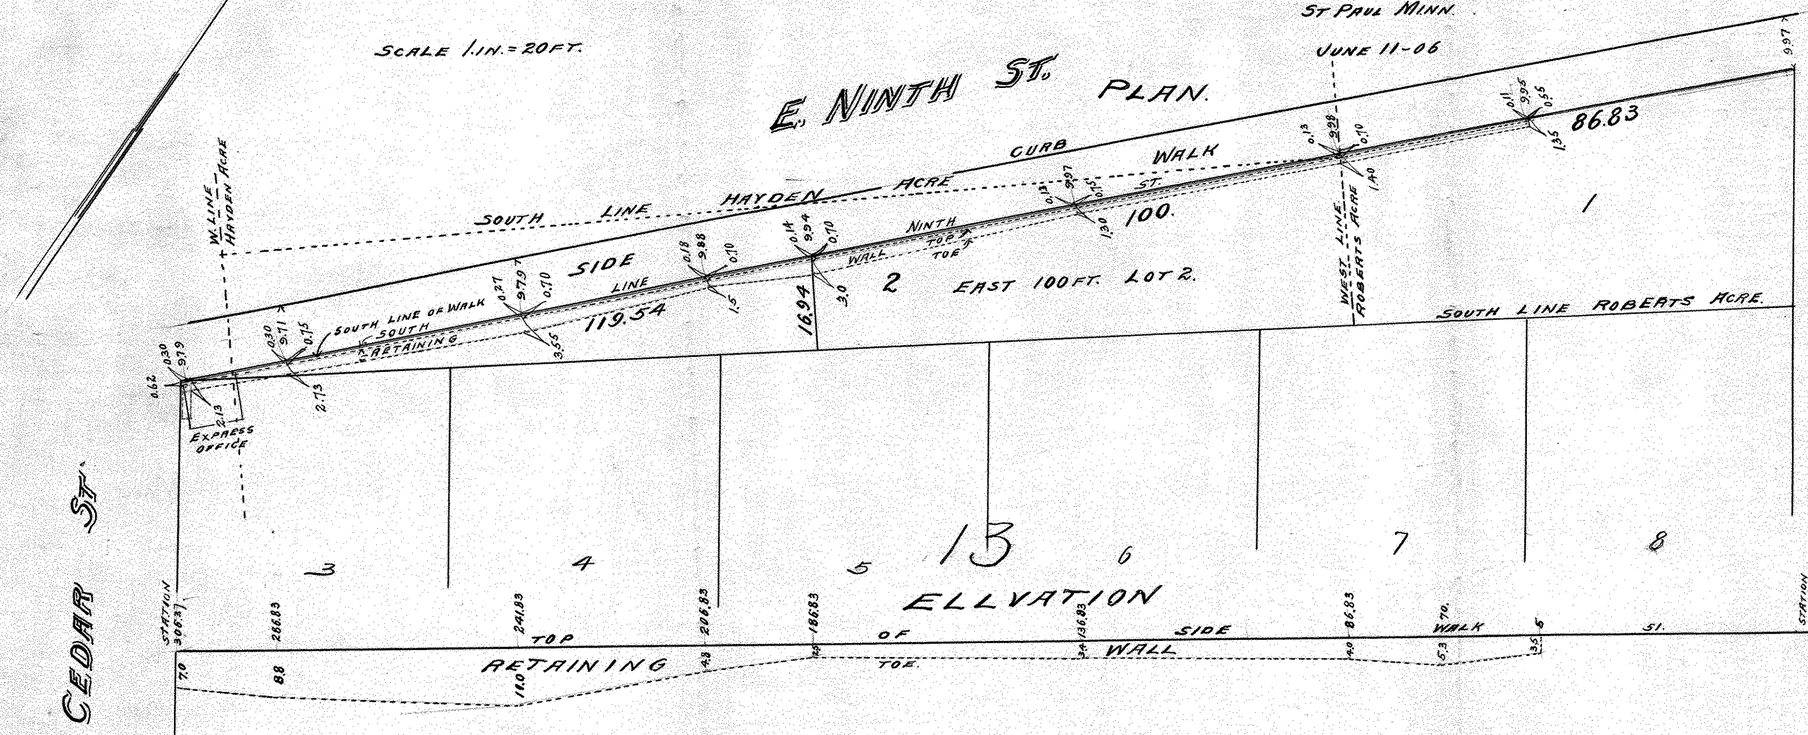

MISC. BOOK NO. 4

Blk. 13. Roberts + Randall's