THE W. 1/2 OF THE S.W. 1/4, SEC. 5, T. 29. R. 22.

AND

THE E. 18, RD'S. OF THE E. 1/2, OF THE S.E. 1/4 SEC. 6. T. 29. R. 22.

JOHN B. IRVINE SURVEYOR.
416. GLOBE BLDG.
ST. PAUL MINN.
SEPT. 07.

Scale 200 ft per inch.

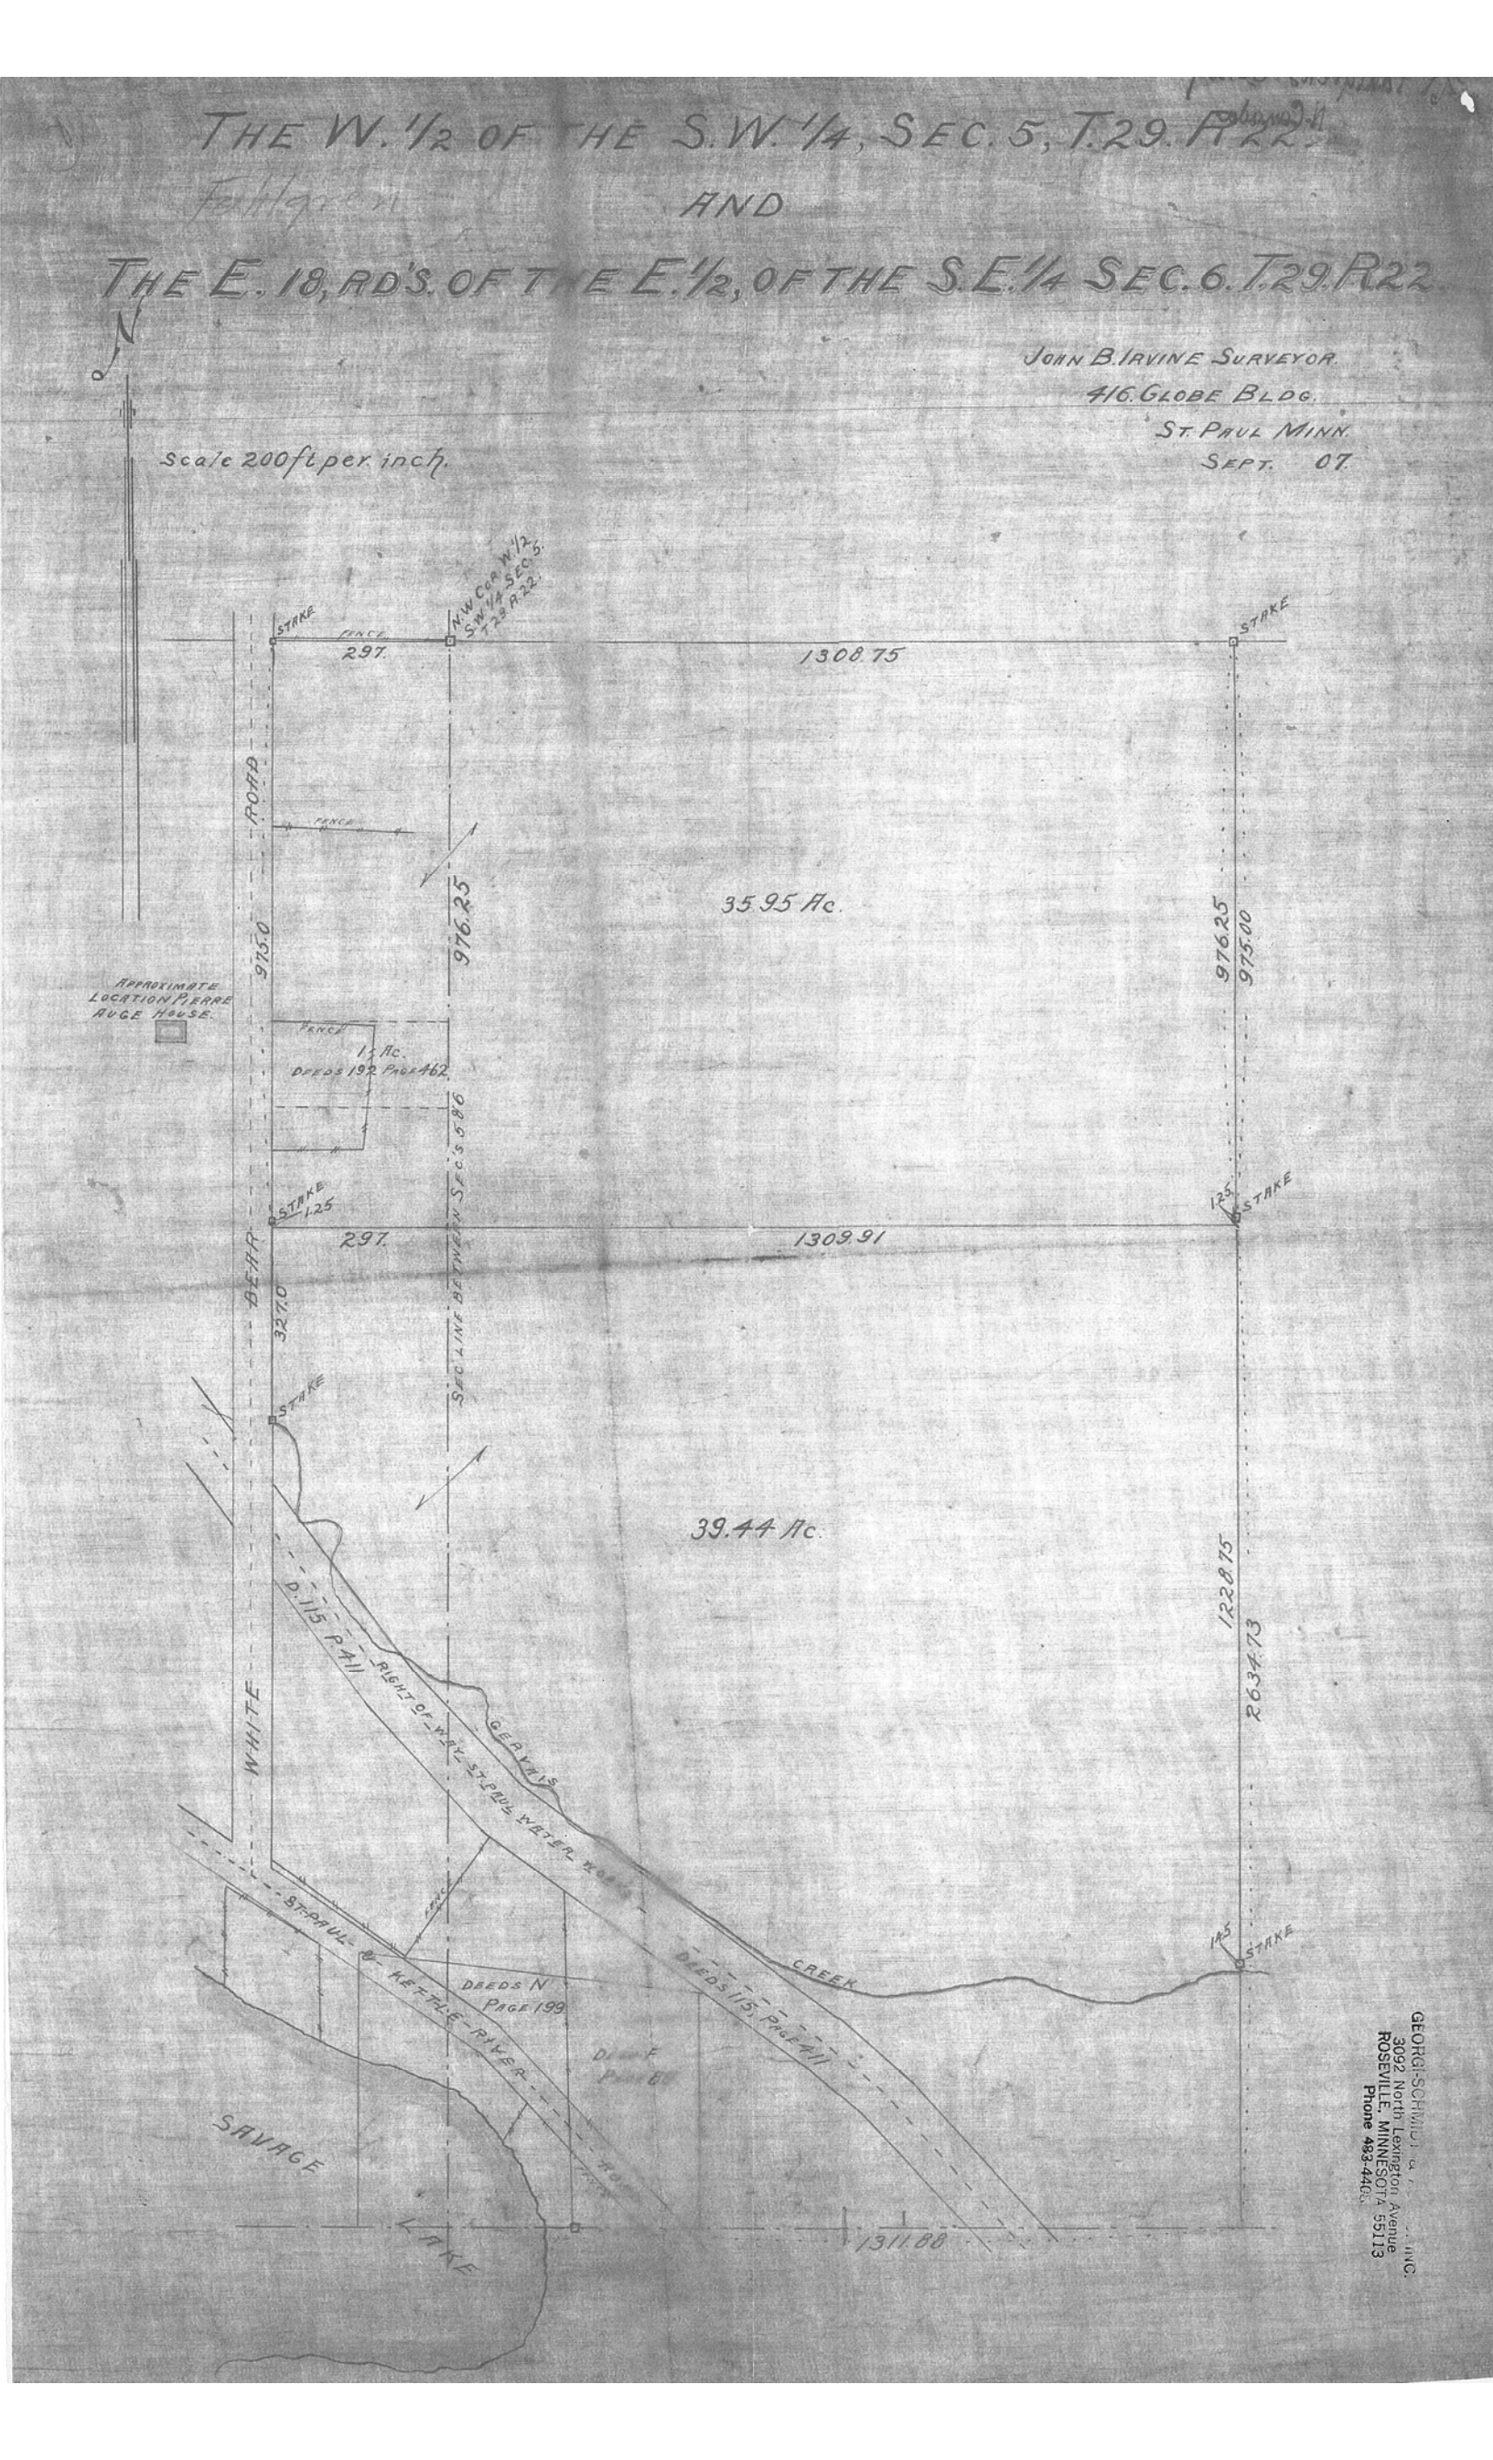

GEORGE SCHMIDT & ASSOCIATES, INC.
3092 North Lexington Avenue
ROSEVILLE, MINNESOTA 55113
Phone 483-4400