


PART of LOT 4 SEC. 36. T. 30. R. 23
 NORTH 1/2 of SOUTH 23 ACRES
 EXCEPT RICE ST & Soo. RR

JOHN B. IRVINE. SURVEYOR
 416 GLOBE BLDG.
 ST PAUL MINN.
 MAY 9 -07.

SCALE 100 ft per. inch.

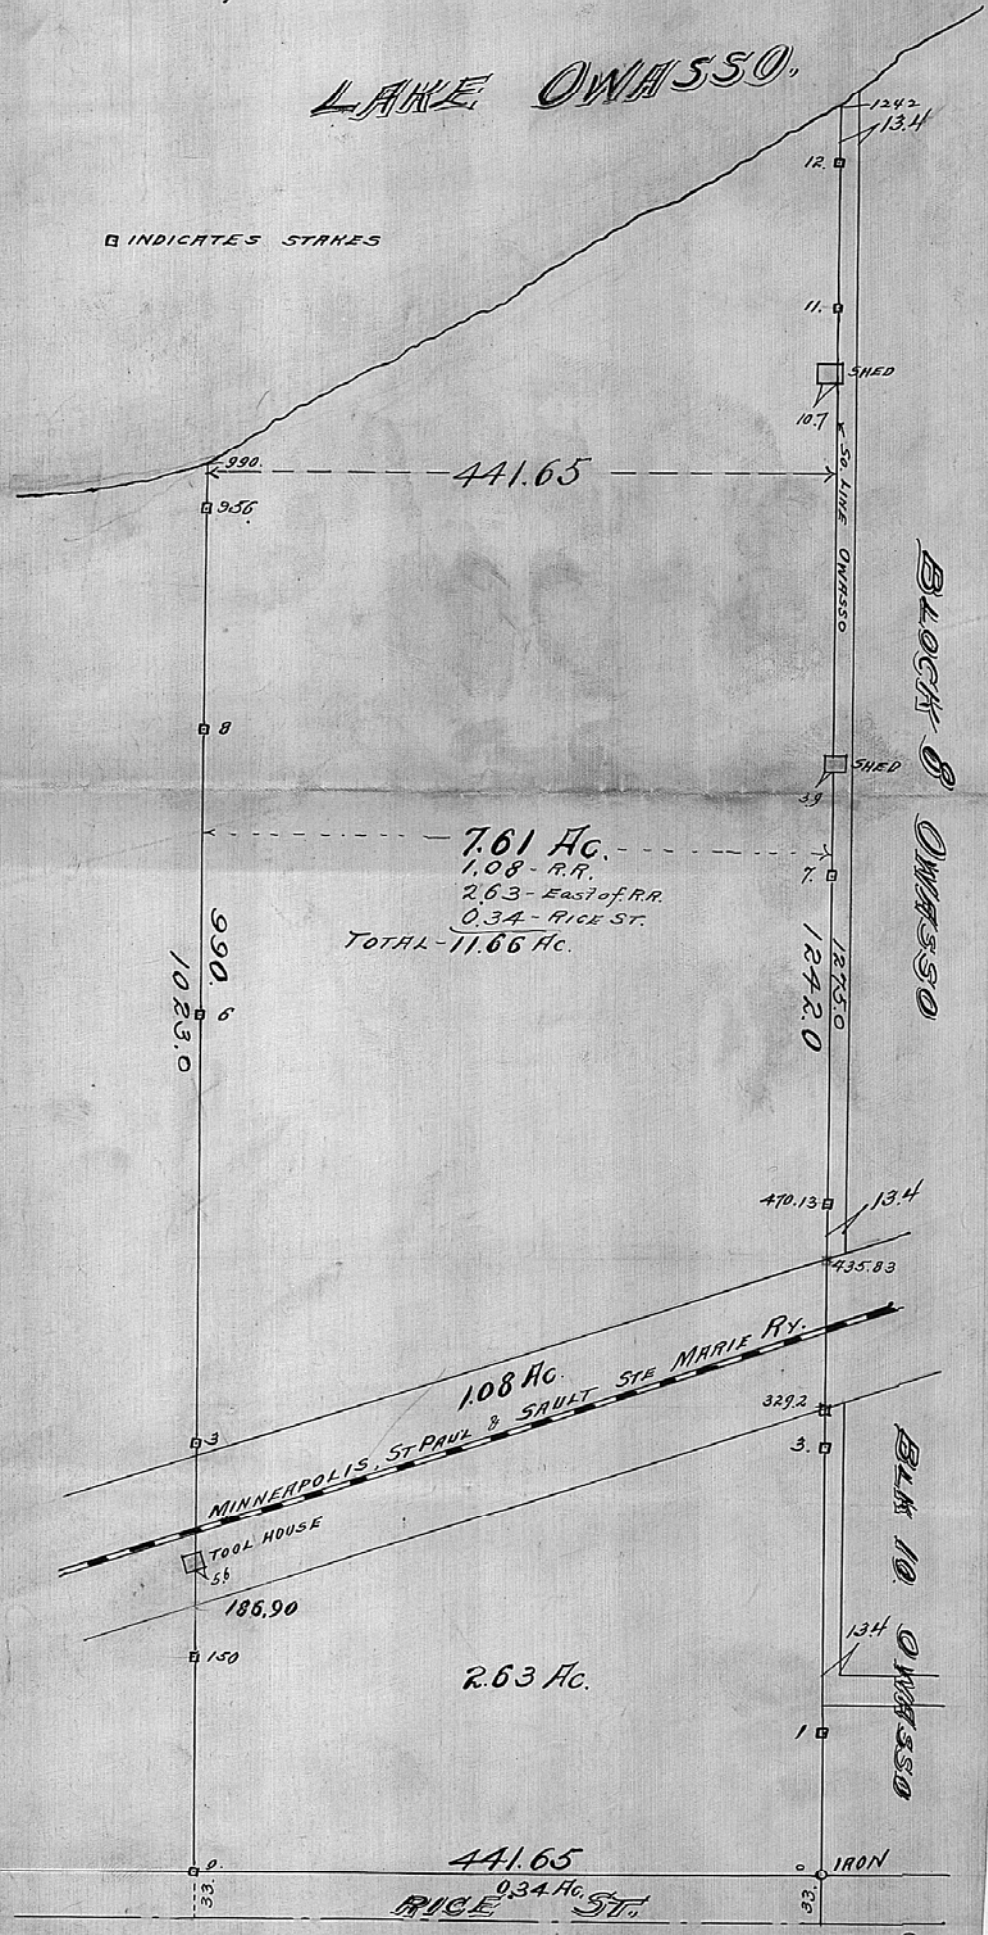

N