


LOT 12 BLOCK 1
BAZILLE & ROBERTS
ADDITION

JOHN B. IRVINE SURVEYOR.
416 GLOBE BLDG.
ST PAUL MINN.
APRIL 4-07

SCALE 20 ft. per inch.

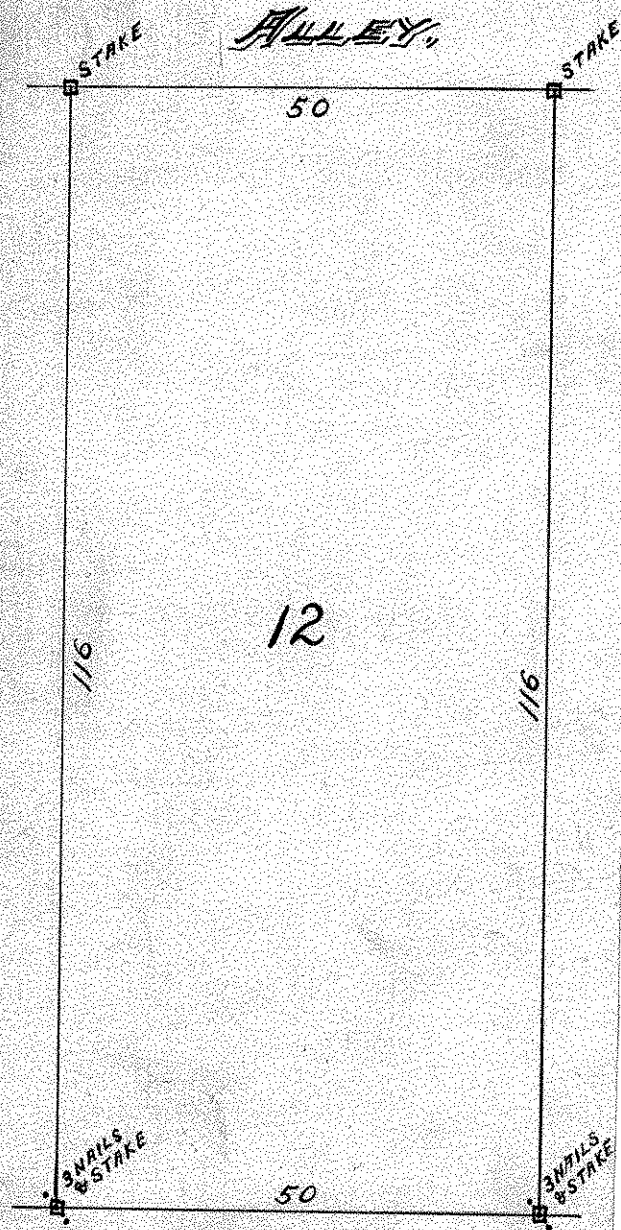

FILLMORE AVE.