MISCELLANEOUS TRACT IN SOUTH 1/2 OF SEC. 31, TOWN 30 RANGE 22.

• indicates Stake

Scale 300. Feet pr. inch

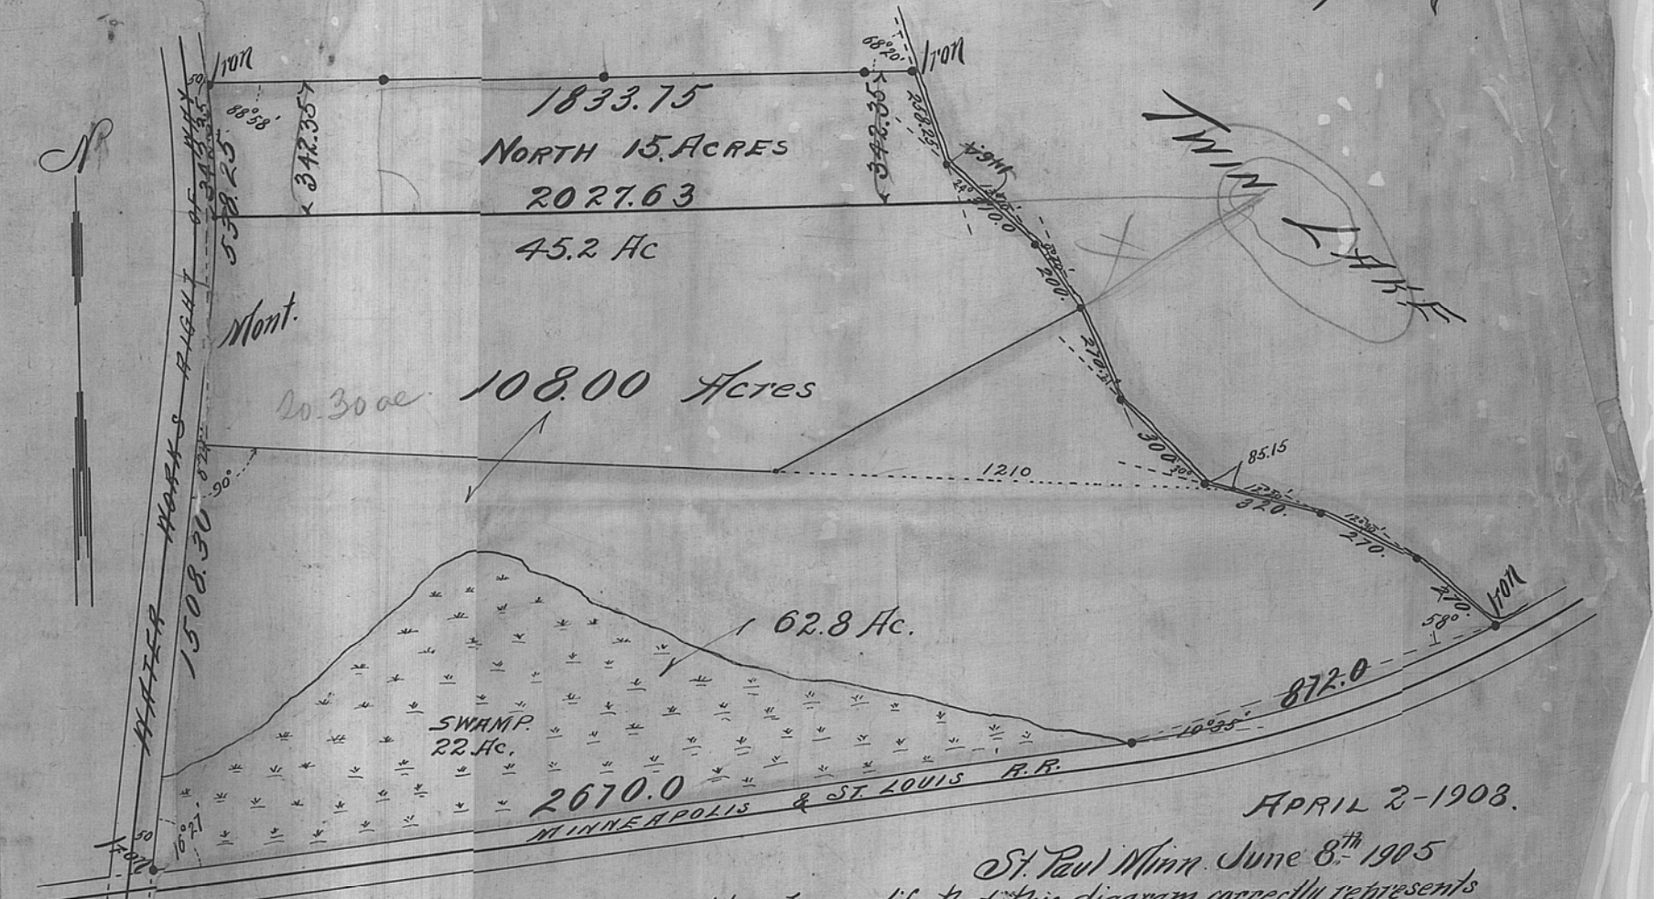

APRIL 2-1908.

St. Paul Minn. June 8th 1905

I hereby certify that this diagram correctly represents "A MISCELLANEOUS TRACT IN THE SOUTH 1/2 OF SEC. 31. T. 30. R. 22" as surveyed by me this day.

John B. Irvine
Surveyor
Room 508 Globe Bldg
St. Paul Minn