S.W.¼ S.E.¼ & W.½ S.E.¼, S.E.¼
SECTION 33 TOWN 30 RANGE 22.

JOHN B. IRVINE SURVEYOR.
SCALE 300 ft per inch.
NOV. 4–1908.
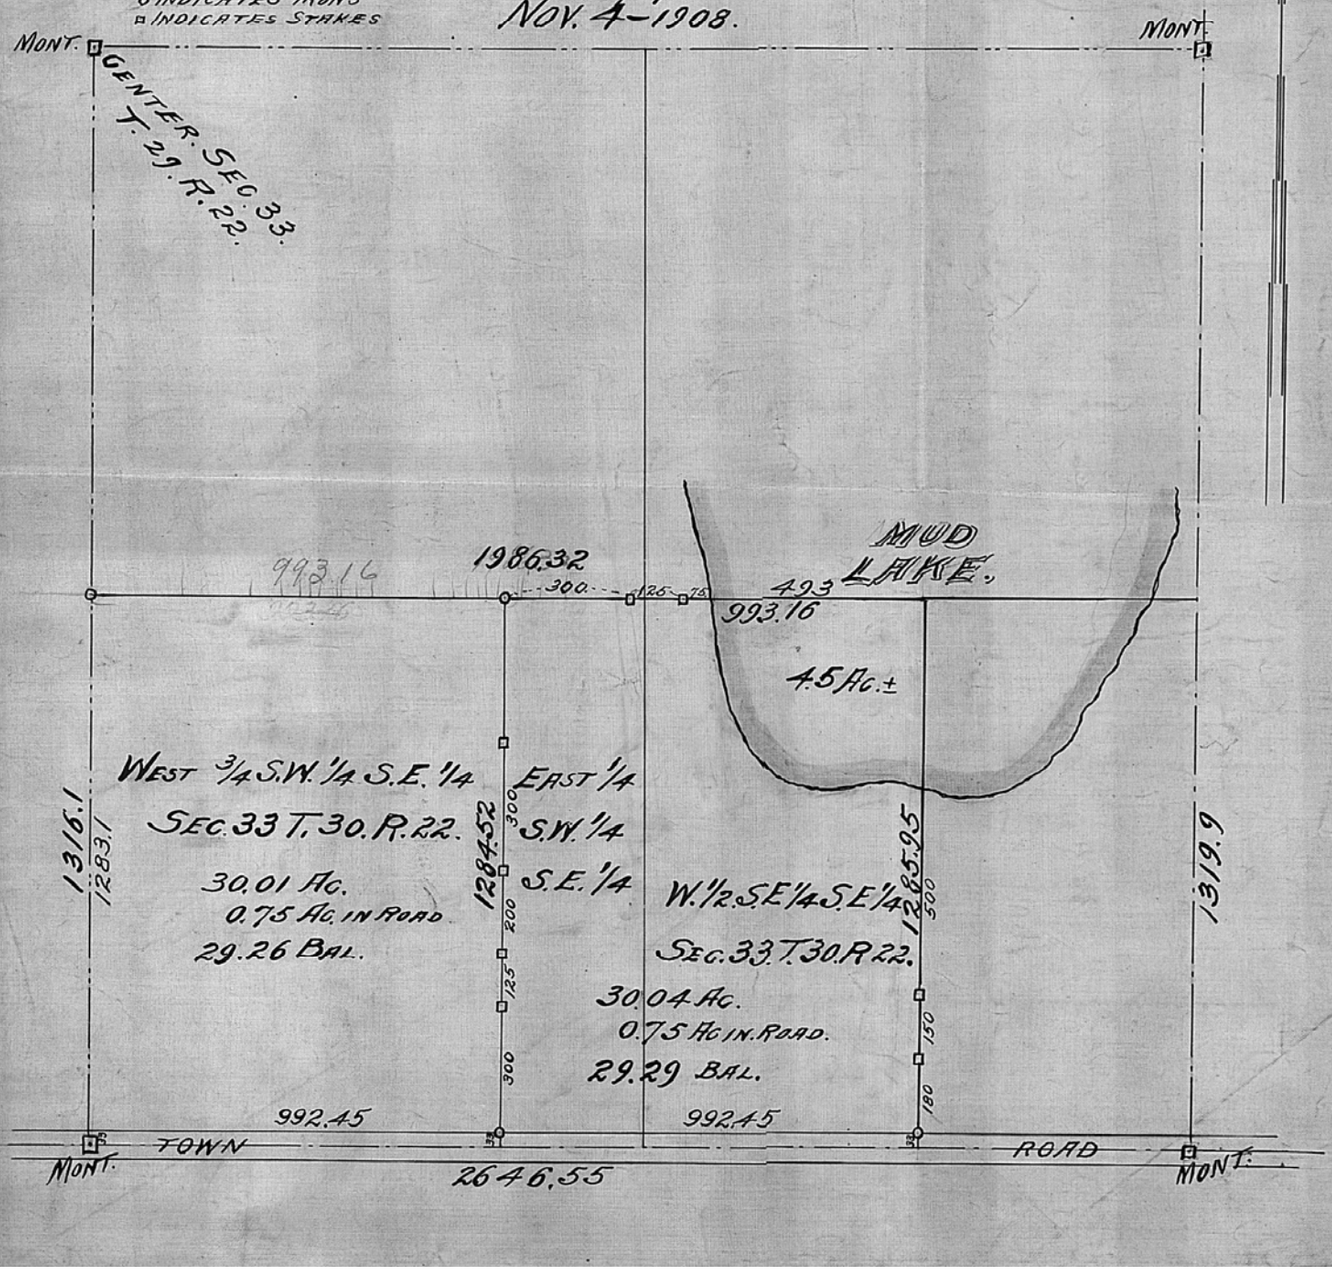
○ INDICATES IRONS
□ INDICATES STAKES