EAST 10 ACRES LOT 1.

SEC. 14 T. 30. R. 23.

JOHN B. IRVINE, SURVEYOR.
ST. PAUL, MINN.
SEPT. 18-08.
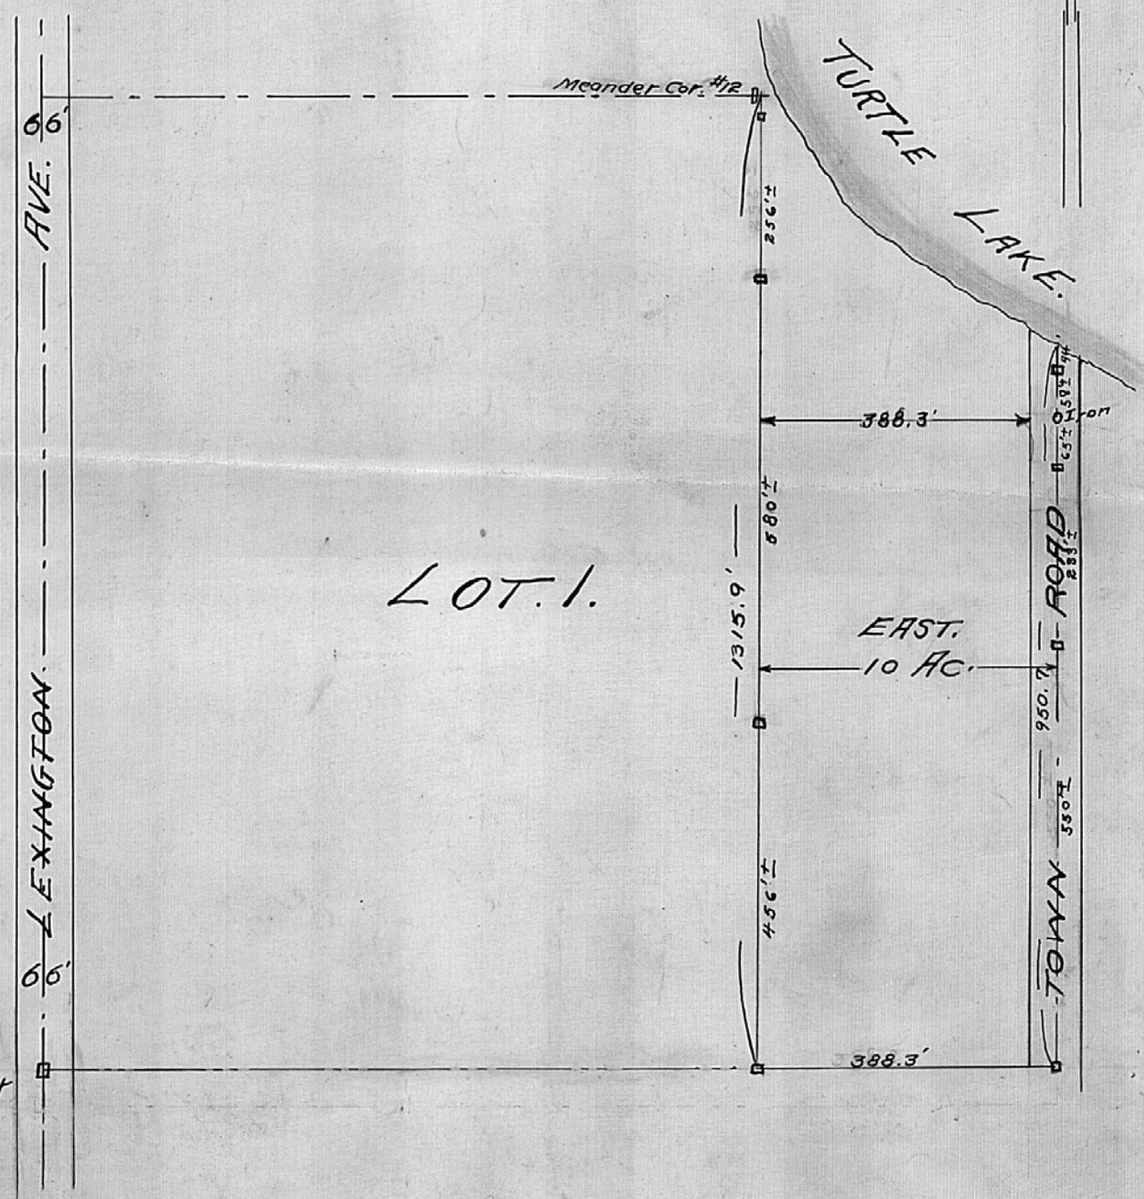
Scale 200 ft per inch.
□ INDICATES STAKE.