W. 1/2. N.E. 1/4. S.E. 1/4.
SEC. 14. T. 30. R. 23.

JOHN B. IRVINE, SURVEYOR.
ST. PAUL MINN.
SEPT. 28-08.

Scale 200 ft. per inch.
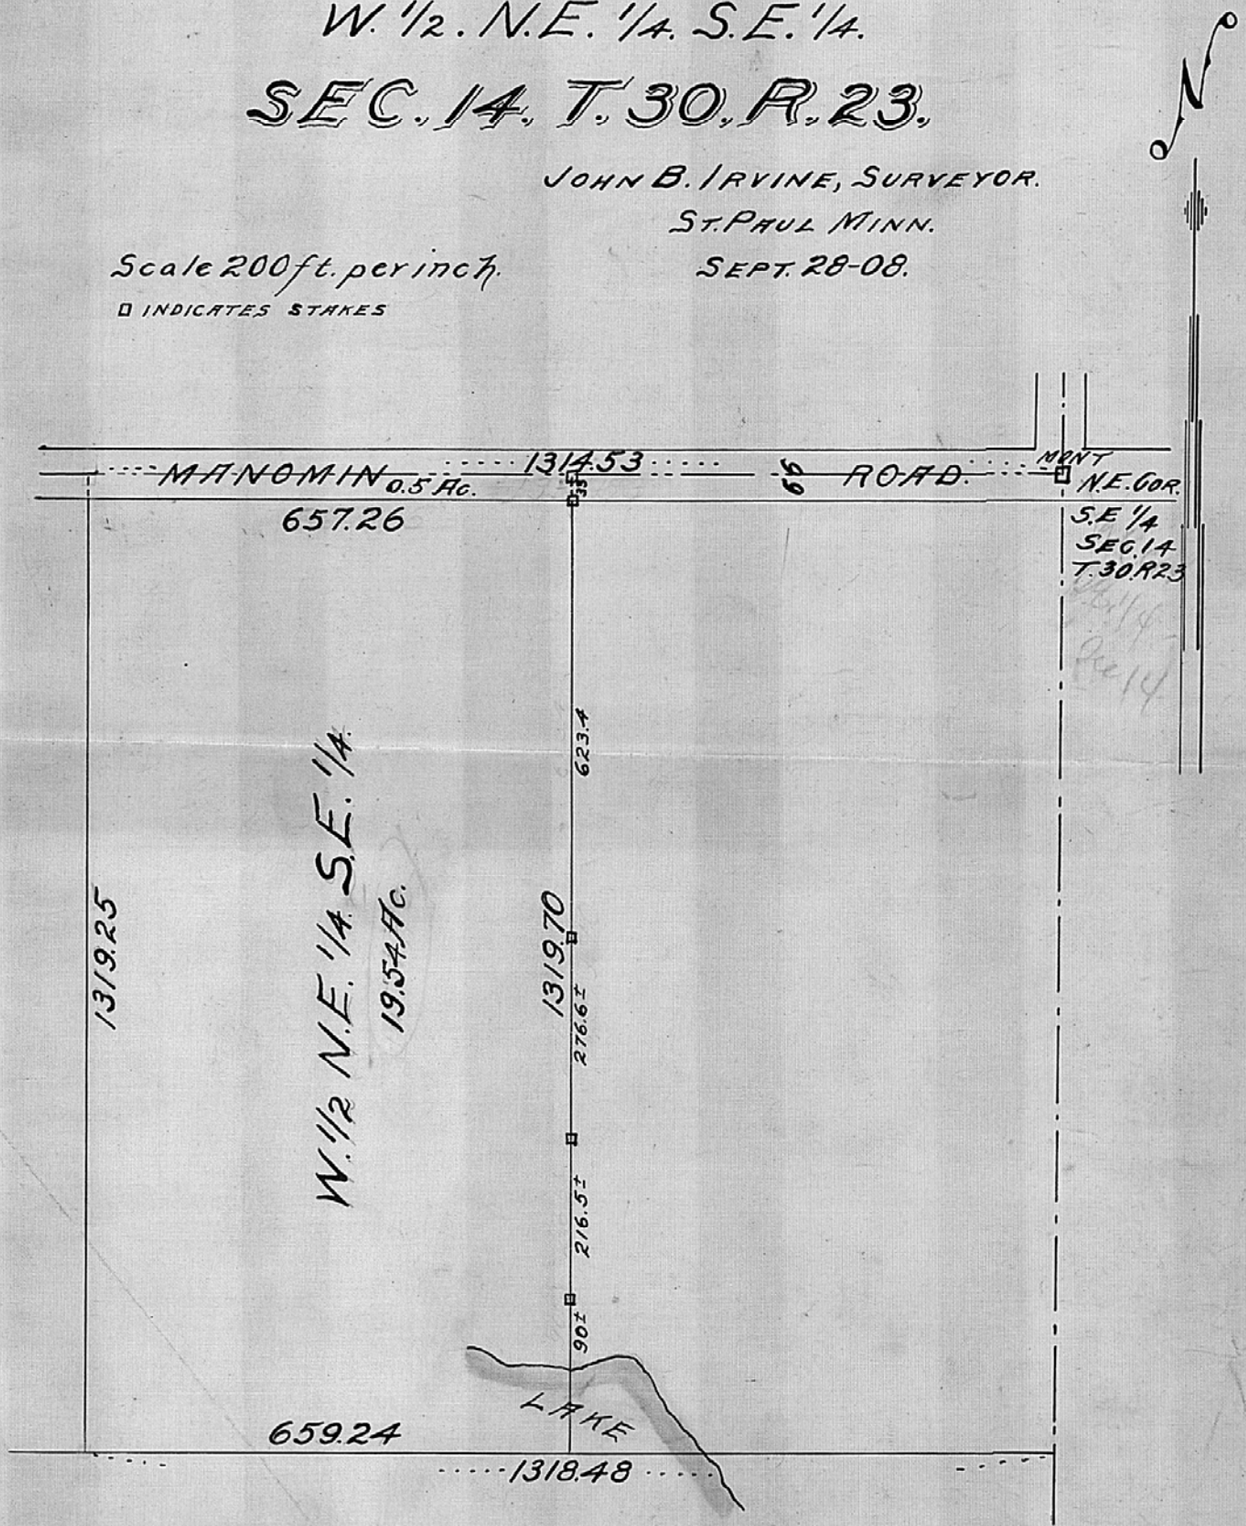
□ INDICATES STAKES