LOT 3 BLOCK 1.

ATWATER ST. ADD.

JOHN B. IRVINE SURVEYOR.
ST. PAUL MINN.
MAY 12-1908
SCALE 20 ft. per. inch.
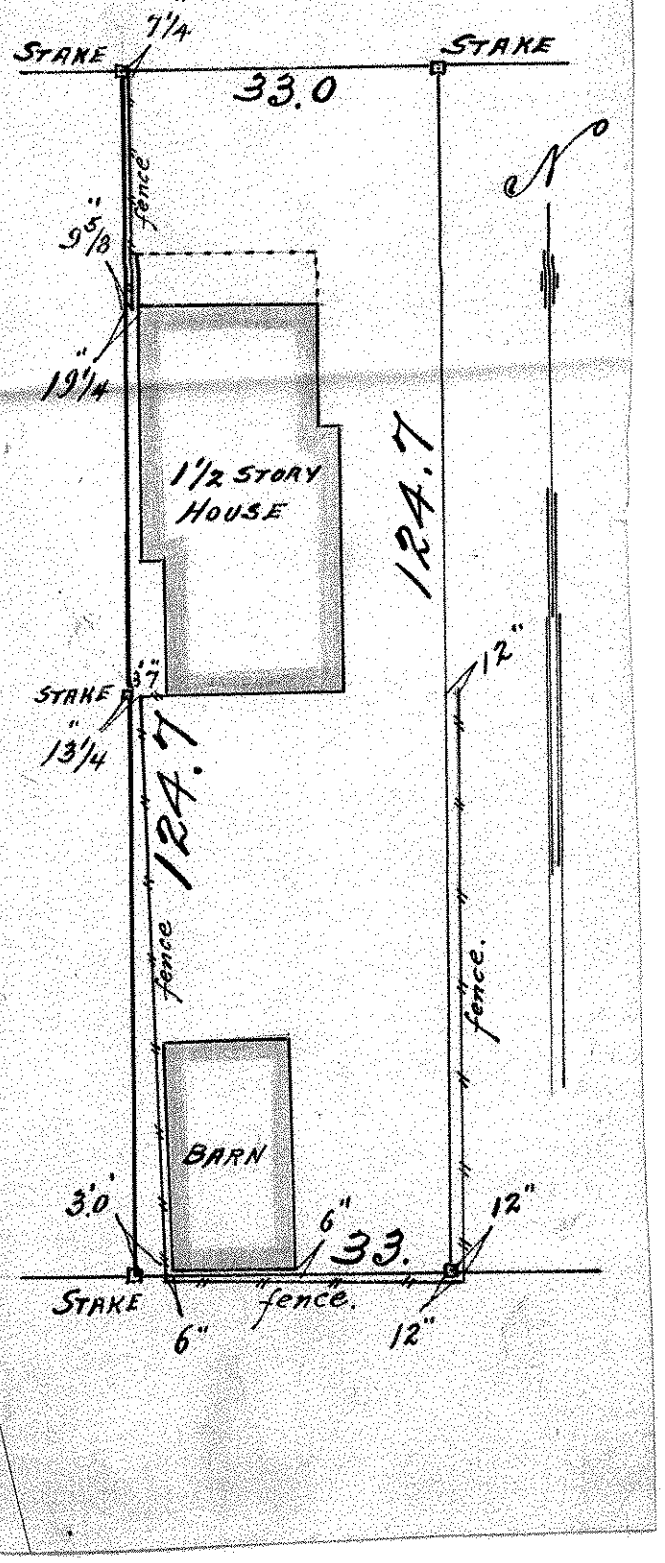
BURGESS ST.