


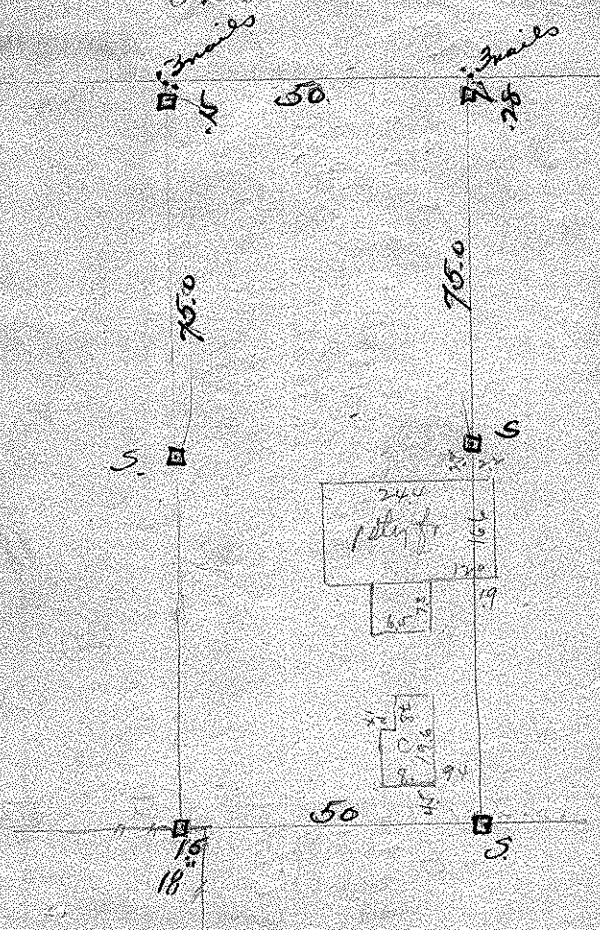

Cherokee



South 50 ft lots 4-5-6  
 Blk 64 Banning  
 + Olivers add

O.H. Biehler  
 808 Cherokee

April 6-1908