


LOT 1 BLOCK 5  
**BREWSTER'S ADD.**

EXCEPT THE EAST 40 ft &  
 THE WEST 50 ft. ALSO  
 THAT PART OF SHERBURNE AVE.  
 VACATED, LYING SOUTH OF  
 LOT 1 EXCEPT THE EAST 40 ft.  
 AND THE WEST 50 ft OF SAID  
 SHERBURNE AVE. VACATED.

N

JOHN B. IRVINE, SURVEYOR.  
 408 GLOBE BLDG.  
 ST. PAUL, MINN.  
 JUNE 10-1909.  
 SCALE 20 ft. per inch.

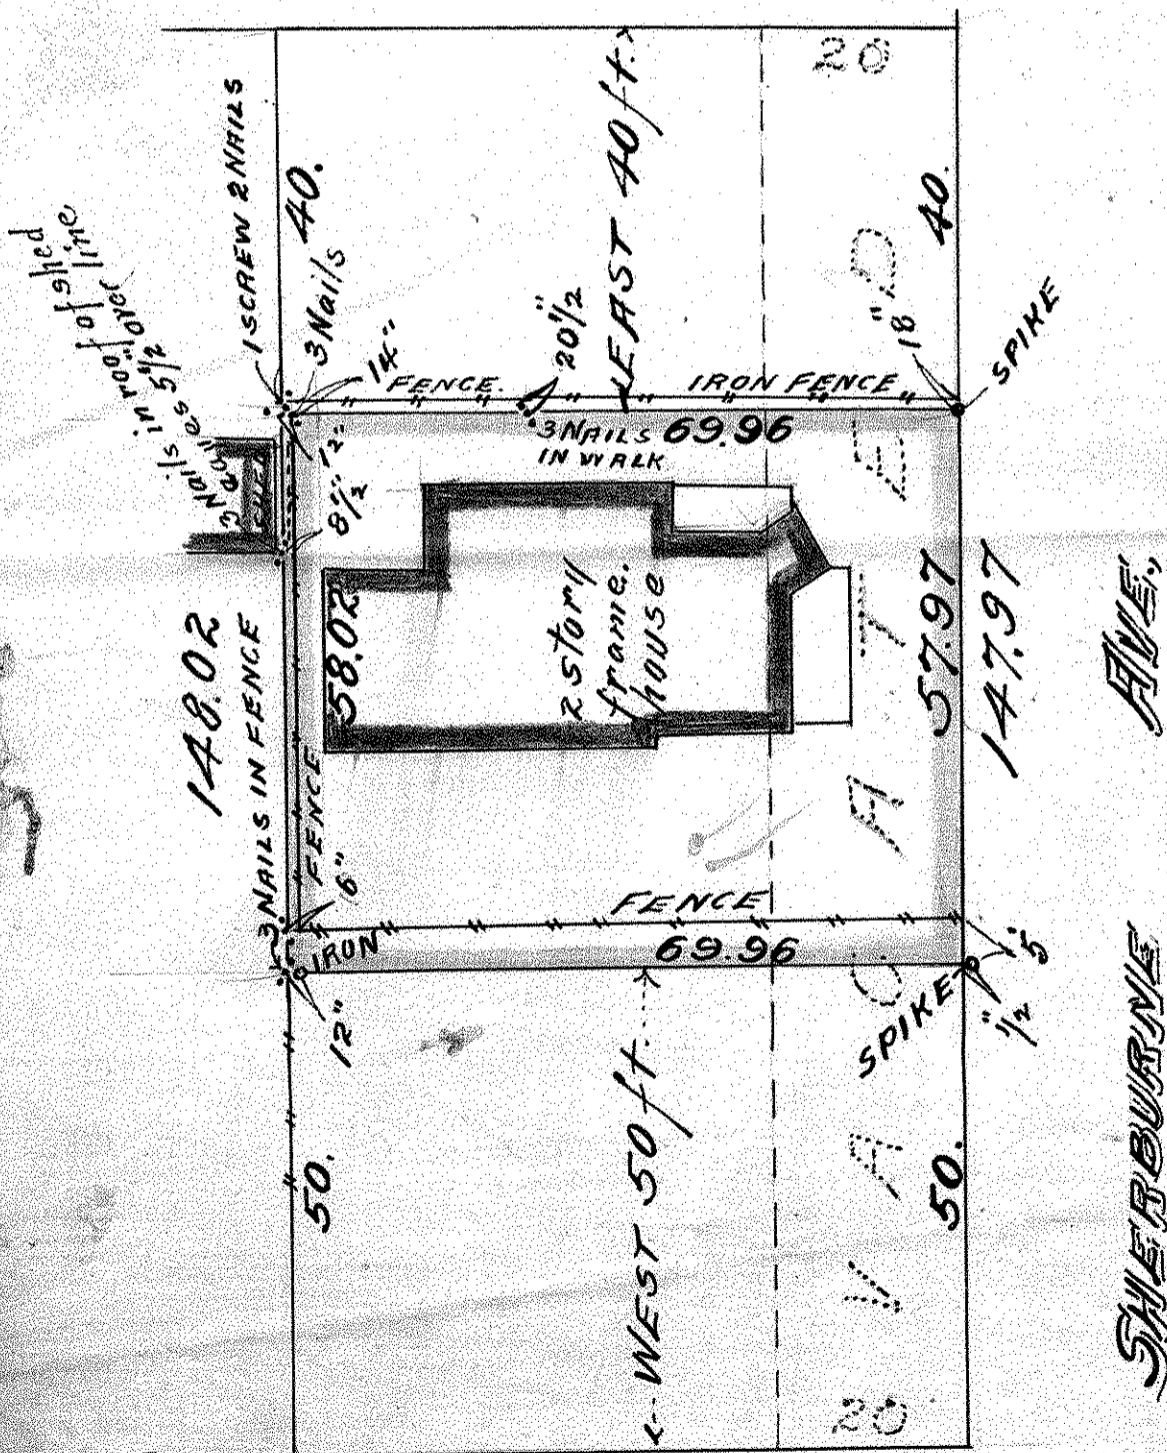

CAPITOL BOULEVARD,