


LOT 12


BIDWELL'S ADD.

EXCEPT THAT PART EAST OF  
THE EAST LINE OF GORMAN AVE.  
AND EXCEPT CURTICE & BELVIDERE STS

JOHN B. IRVINE, SURVEYOR.  
408 GLOBE BLDG.  
ST. PAUL MINN.  
OCT 8-1909.  
SCALE 40 FT. PER INCH.  
TOTAL ACRES 3.15

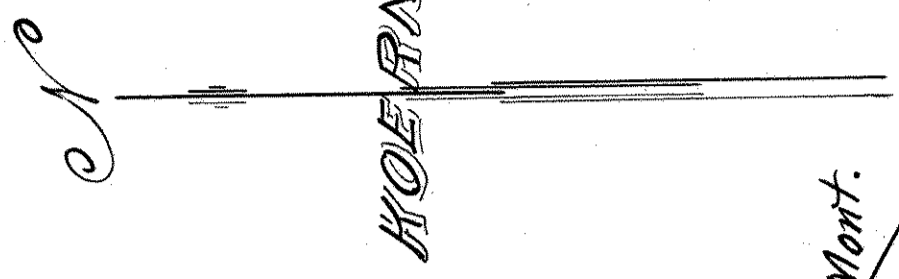


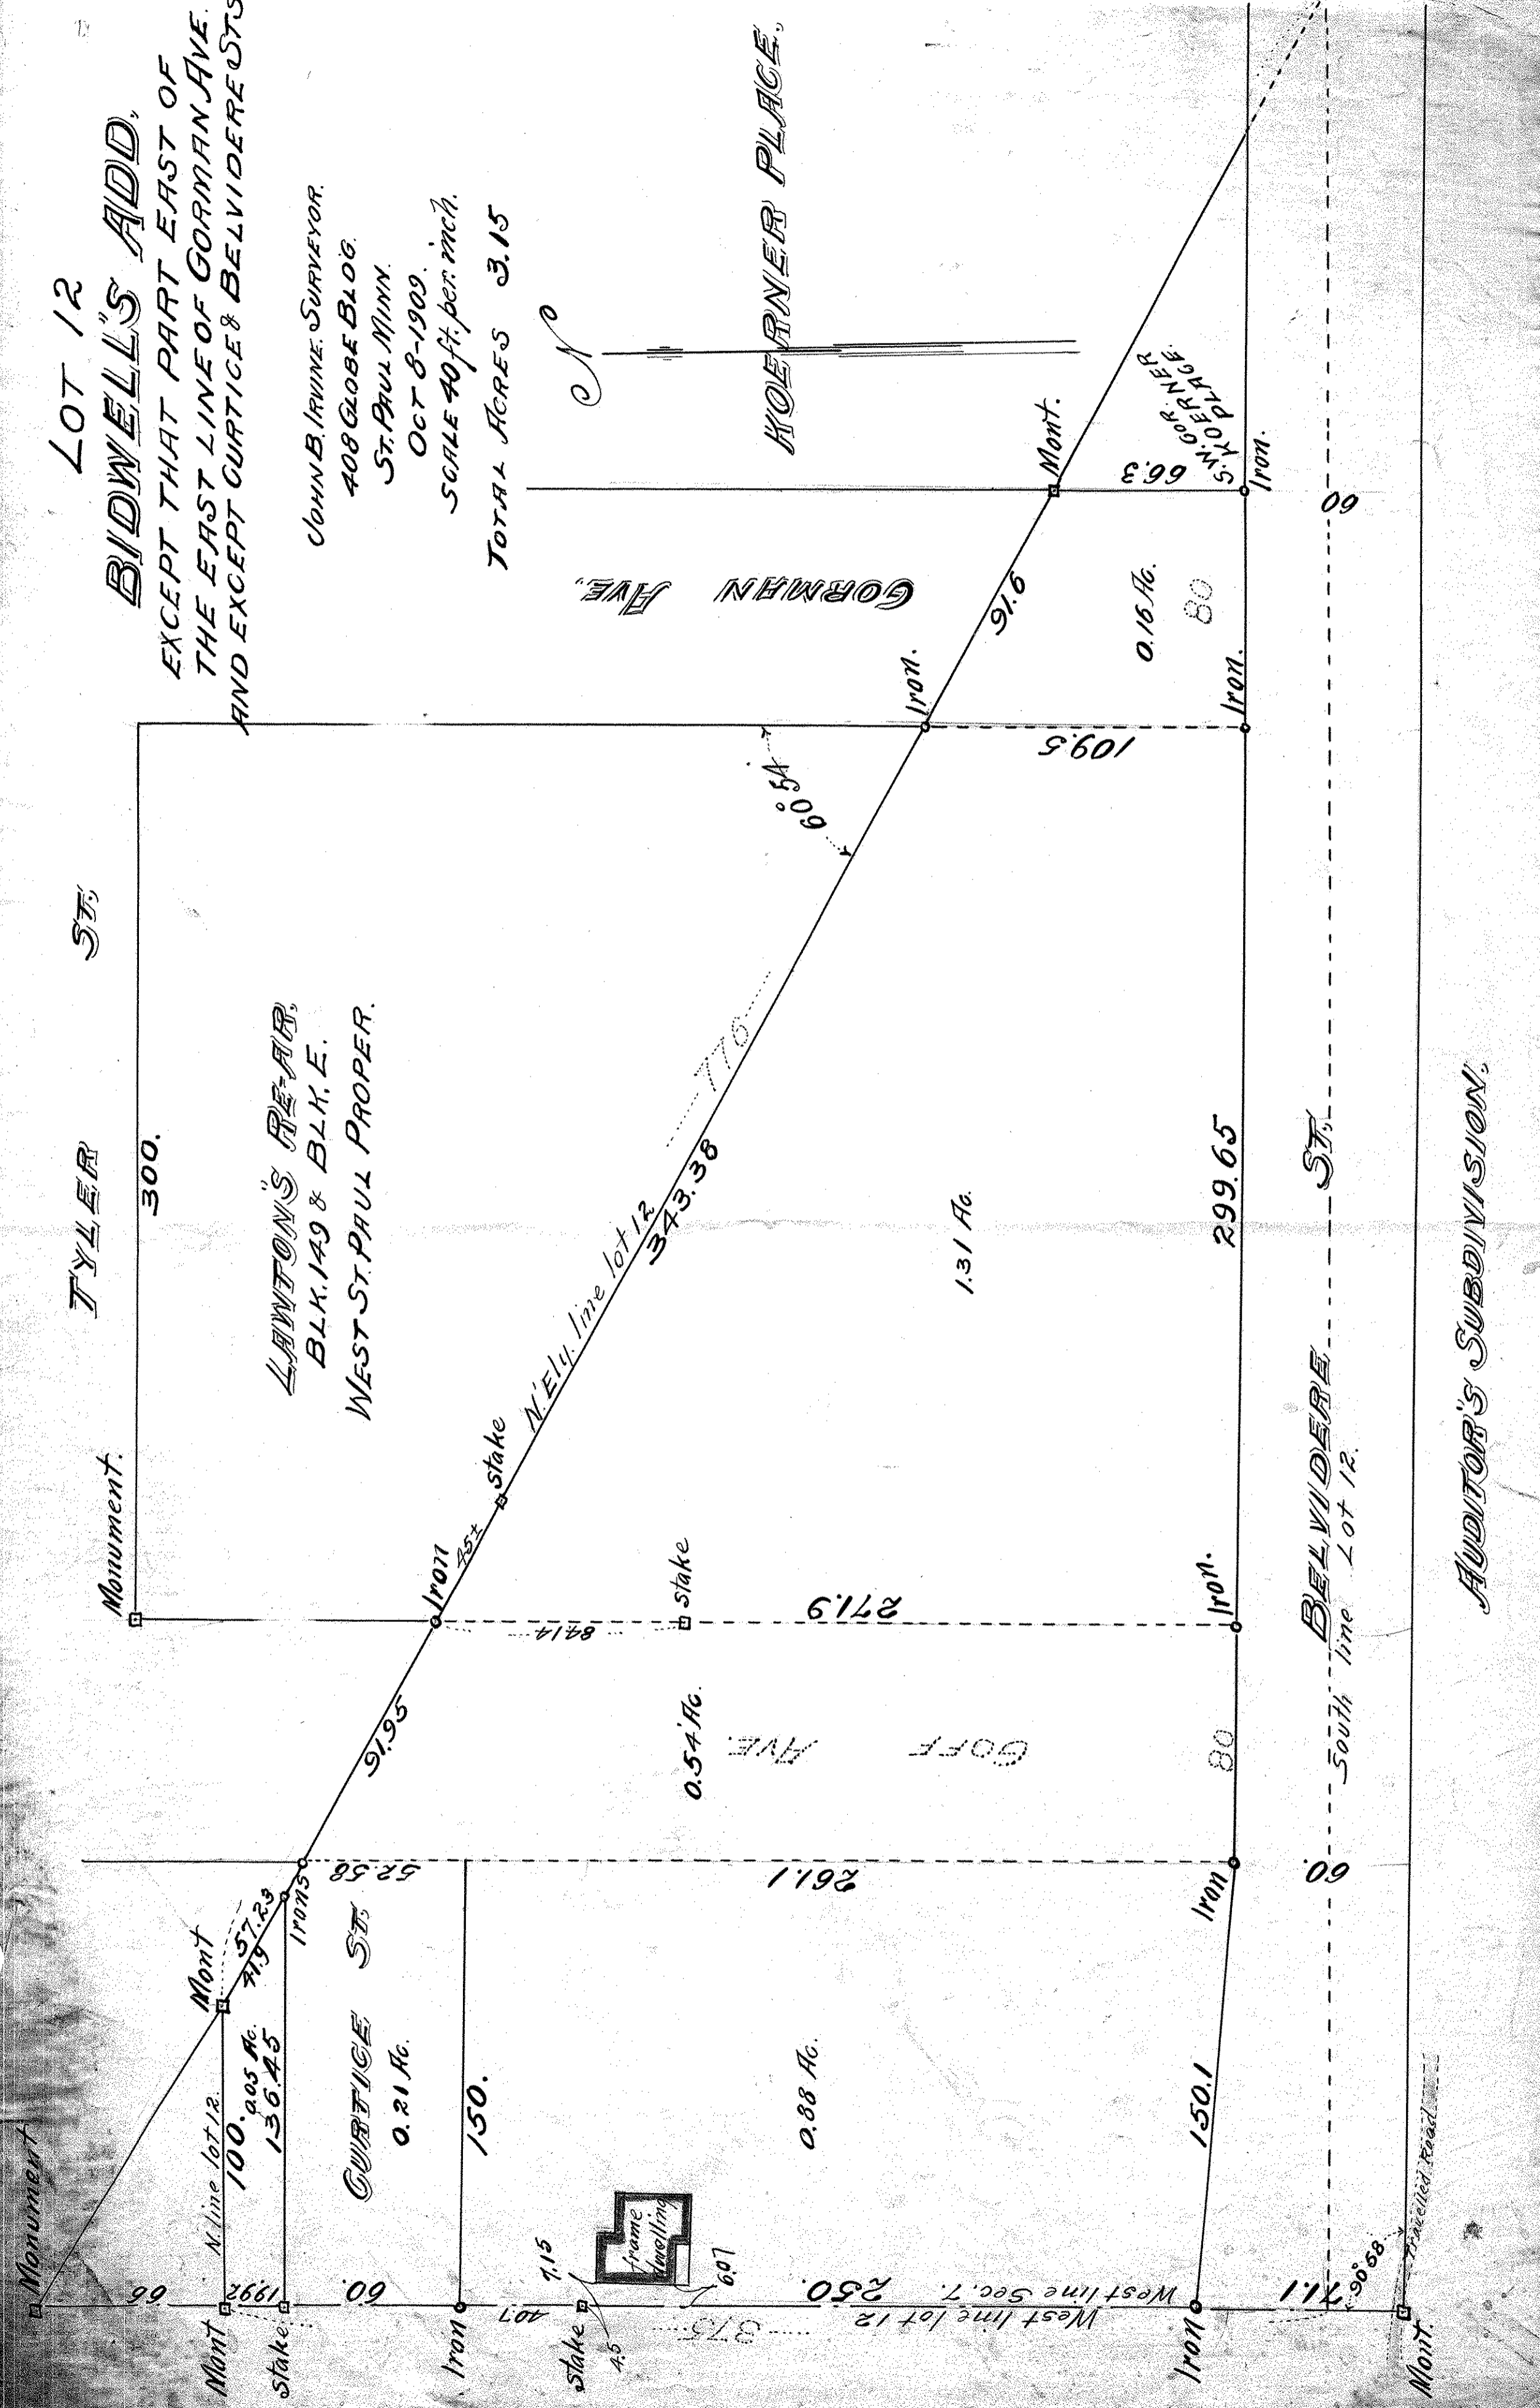

TYLER ST

TYLER ST

ST

BELVIDERE ST

South line Lot 12

AUDITOR'S SUBDIVISION.

LANTON'S REAR.  
BLK. 149 & BLK. E.  
WEST ST PAUL PROPER.

GORMAN AVE.

GOLF AVE.

CURTICE ST

South line Lot 12

Monument

Monument

Monument

Monument

Stake

Stake

Iron

Stake

Stake

Iron

Iron

Iron

Iron

Iron

Iron

Iron

























































300.


770

91.95

84.14

271.9

0.54 Ac.

1.31 Ac.

299.65

80

60













109.5

91.6

66.3

80




















199.8

100.905 Ac.


110.75

150.

150.1


















407

1.15

4.5

6.07

375

250


















West line lot 12

West line Sec. 7

West line lot 12

West line lot 12

frame dwelling

stake
























