LOT 1 BLOCK 5
BREWSTER'S ADD.

EXCEPT THE EAST 40 ft & THE WEST 50 ft. ALSO THAT PART OF SHERBURNE AVE. VACATED, LYING SOUTH OF LOT 1 EXCEPT THE EAST 40 ft. AND THE WEST 50 ft OF SAID SHERBURNE AVE. VACATED.
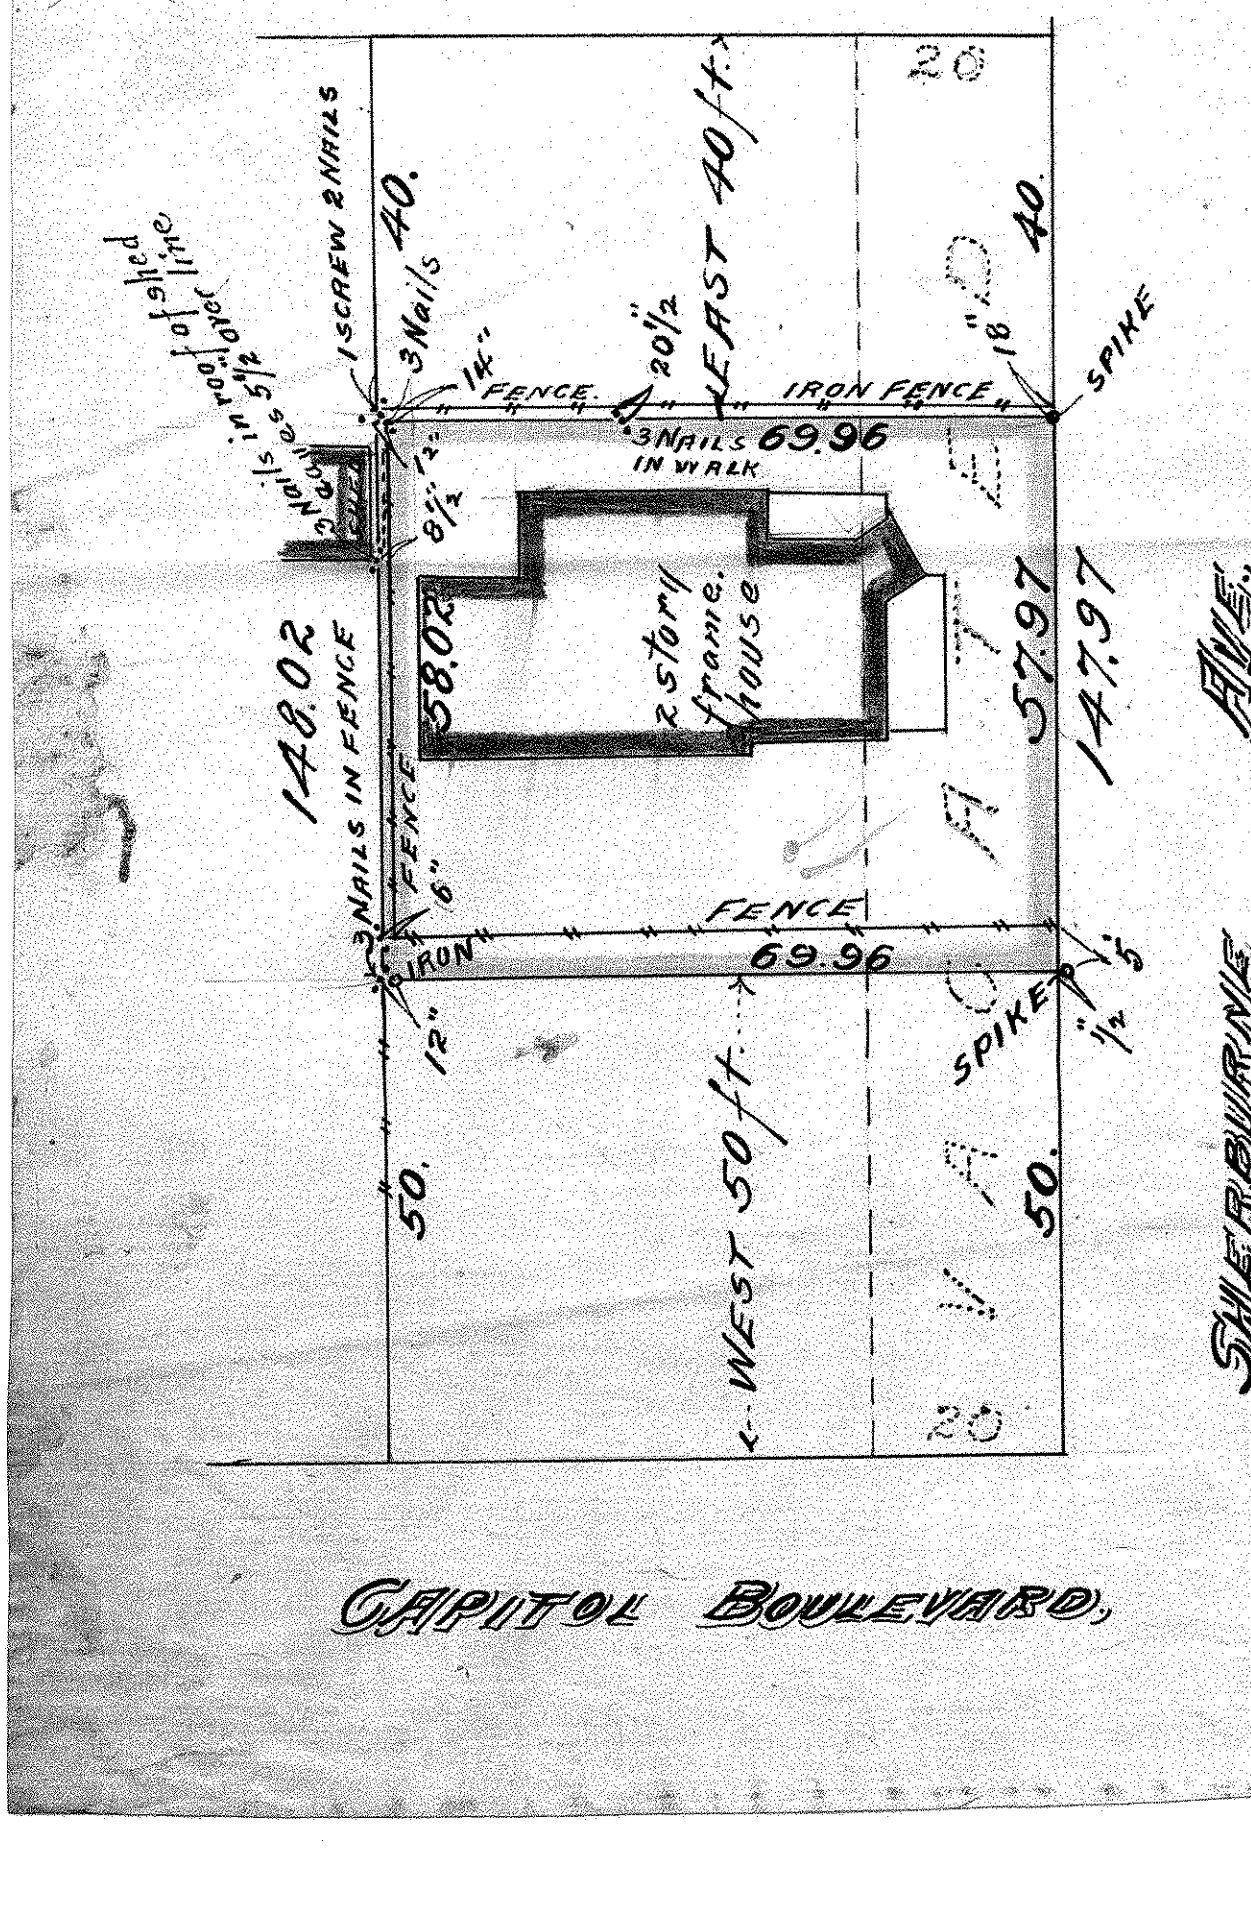
JOHN B. IRVINE, SURVEYOR.
408 GLOBE BLDG.
ST. PAUL, MINN.
JUNE. 10-1909.
SCALE 20 ft. per. inch.