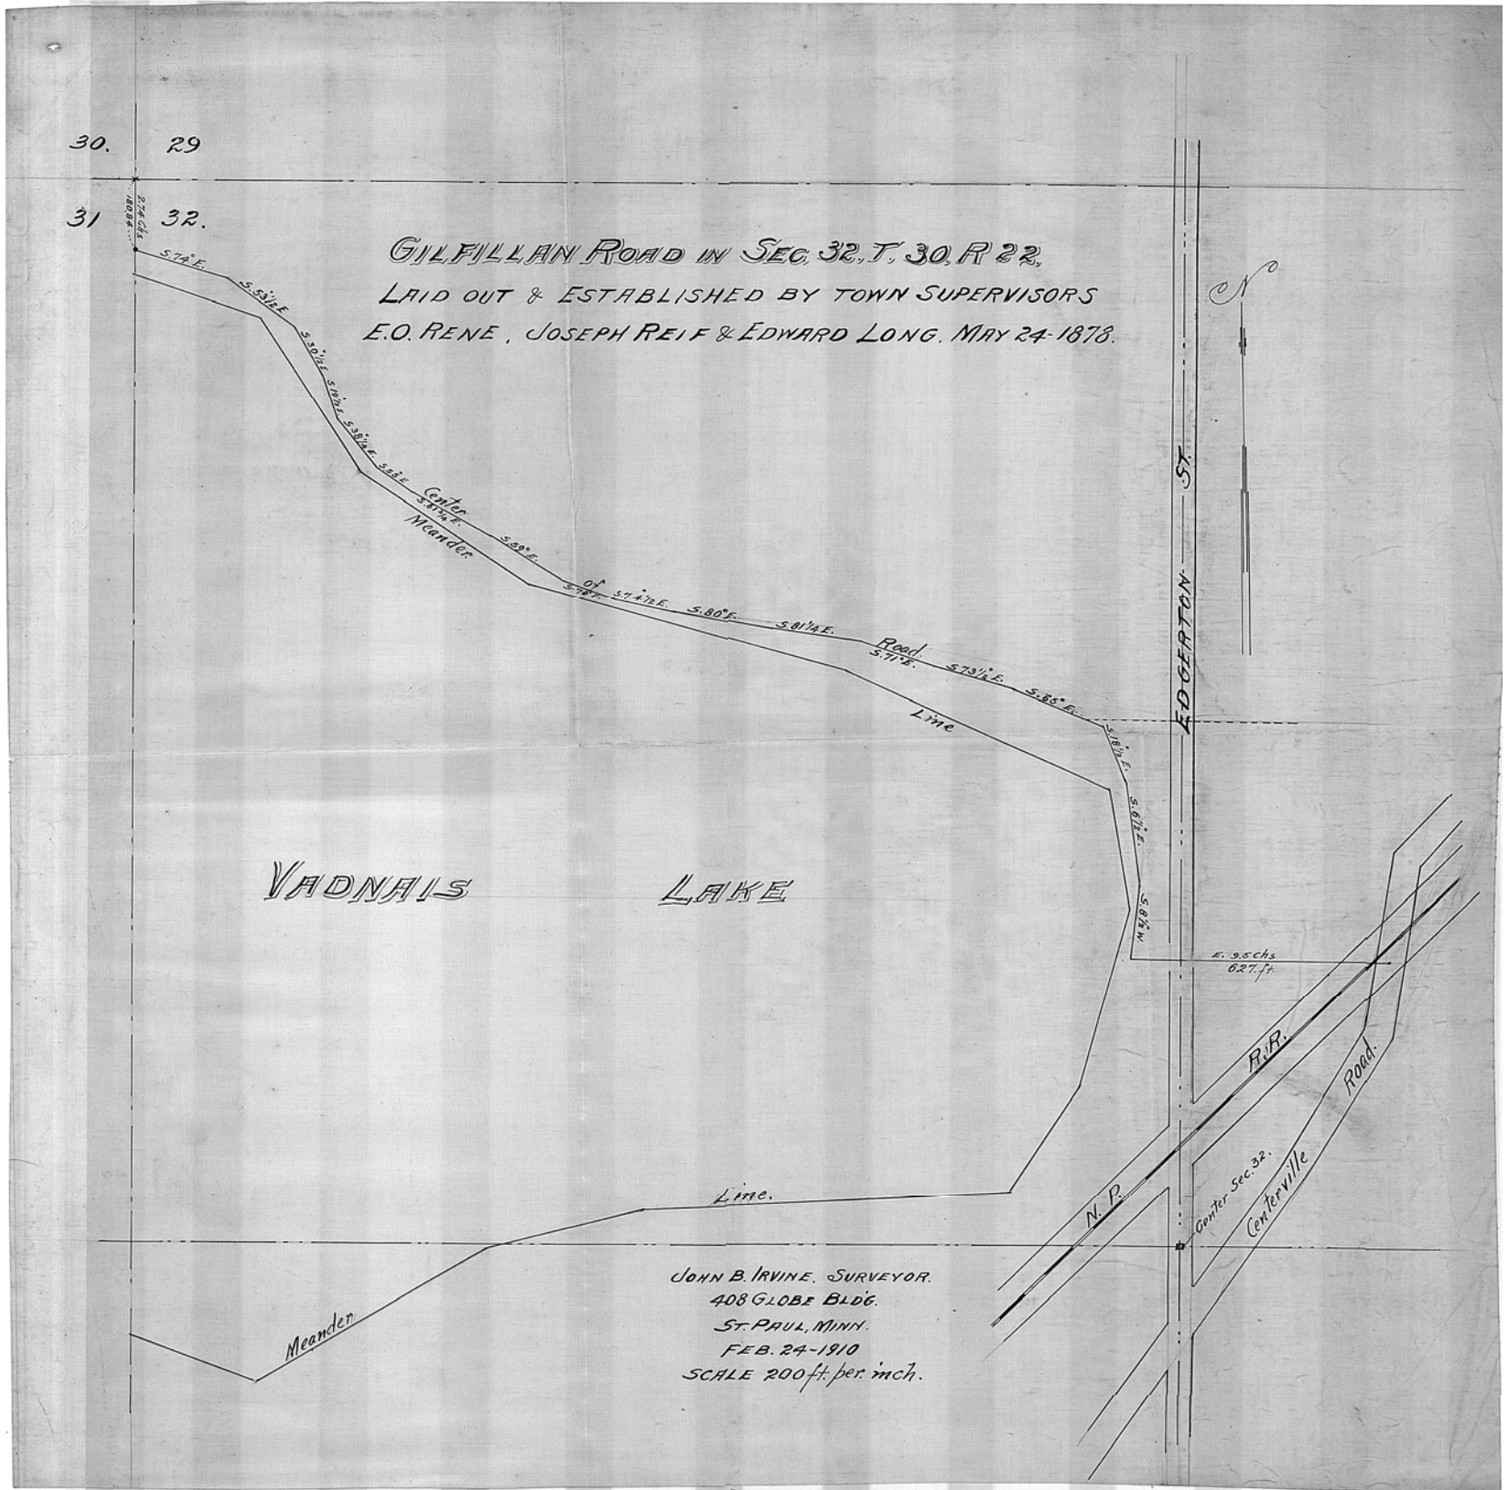

GILFILLAN ROAD IN SEC. 32, T. 30, R 22.
LAID OUT & ESTABLISHED BY TOWN SUPERVISORS
E.O. RENE, JOSEPH REIF & EDWARD LONG. MAY 24-1878.
30.
29
31
32.
2.74 chs
180.84
S.74°E.
S.53½E.
S.30½E.
S.38½E.
S.55°E.
Center
Meander
S.59°E.
of
S.74°E.
S.74½E.
S.80°E.
S.81¼E.
Road
S.71°E.
S.73½E.
S.85°E.
S.18½E.
S.6½E.
S.8½W.
Line
EDGERTON ST.
N
VADNAIS LAKE
E. 9.5 chs
627 ft.
R.R.
N.P.
Center Sec. 32.
Centerville Road.
Line.
Meander
JOHN B. IRVINE. SURVEYOR.
408 GLOBE BLDG.
ST. PAUL, MINN.
FEB. 24-1910
SCALE 200 ft. per inch.