

North line Lot 5

SW SE
SW SE

LOT 5 SEC. 33, T. 30, R. 23

JOHN B. IRVINE, SURVEYOR.
408 GLOBE BLDG.
ST. PAUL, MINN.
APRIL 6, 1910.
SCALE 100 ft. per inch.

LOT 5
37.22 Ac.


JAMES POWERS
25.98 Ac.

Meadow line

LAKE JOHANNIA

WALTER BEAR & MUNDUS VIEW ROAD

WEST BRIGHAMTON RD

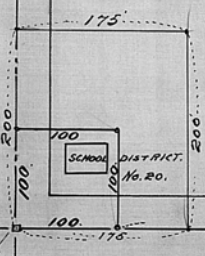



FOUN 530 ROAD
630

MARTIN HOSLI
11.24 Ac.

884.8

536

920

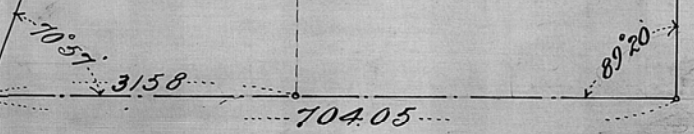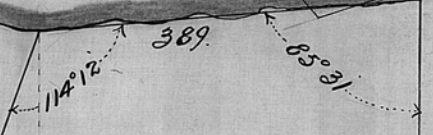

WEST

1/4 Cor. on
south side
Section 33
T. 30, R. 23

X16

LOT 5, SEC. 33, T. 30, R. 23.

JOHN B. IRVINE SURVEYOR.
408 GLOBE BLDG.
ST. PAUL MINN.
APRIL 6-1910.
SCALE 200 ft. per. inch.

JAN. 10-1910.

