


No. *12*
LOTS 4 & 5 & PART OF LOT 2.
 LYING BETWEEN THE E'LY LINE OF LOT 5 &
 THE W'LY LINE OF LOT 4 PRODUCED TO NINTH ST.
BLOCK 13.
ROBERT & RANDALL'S ADD.

JOHN BIRVINE, SURVEYOR.
 408 GLOBE BLD'G.
 ST PAUL, MINN.
 FEB. 23-10.
 SCALE 10ft per inch.

ST.

E NINTH

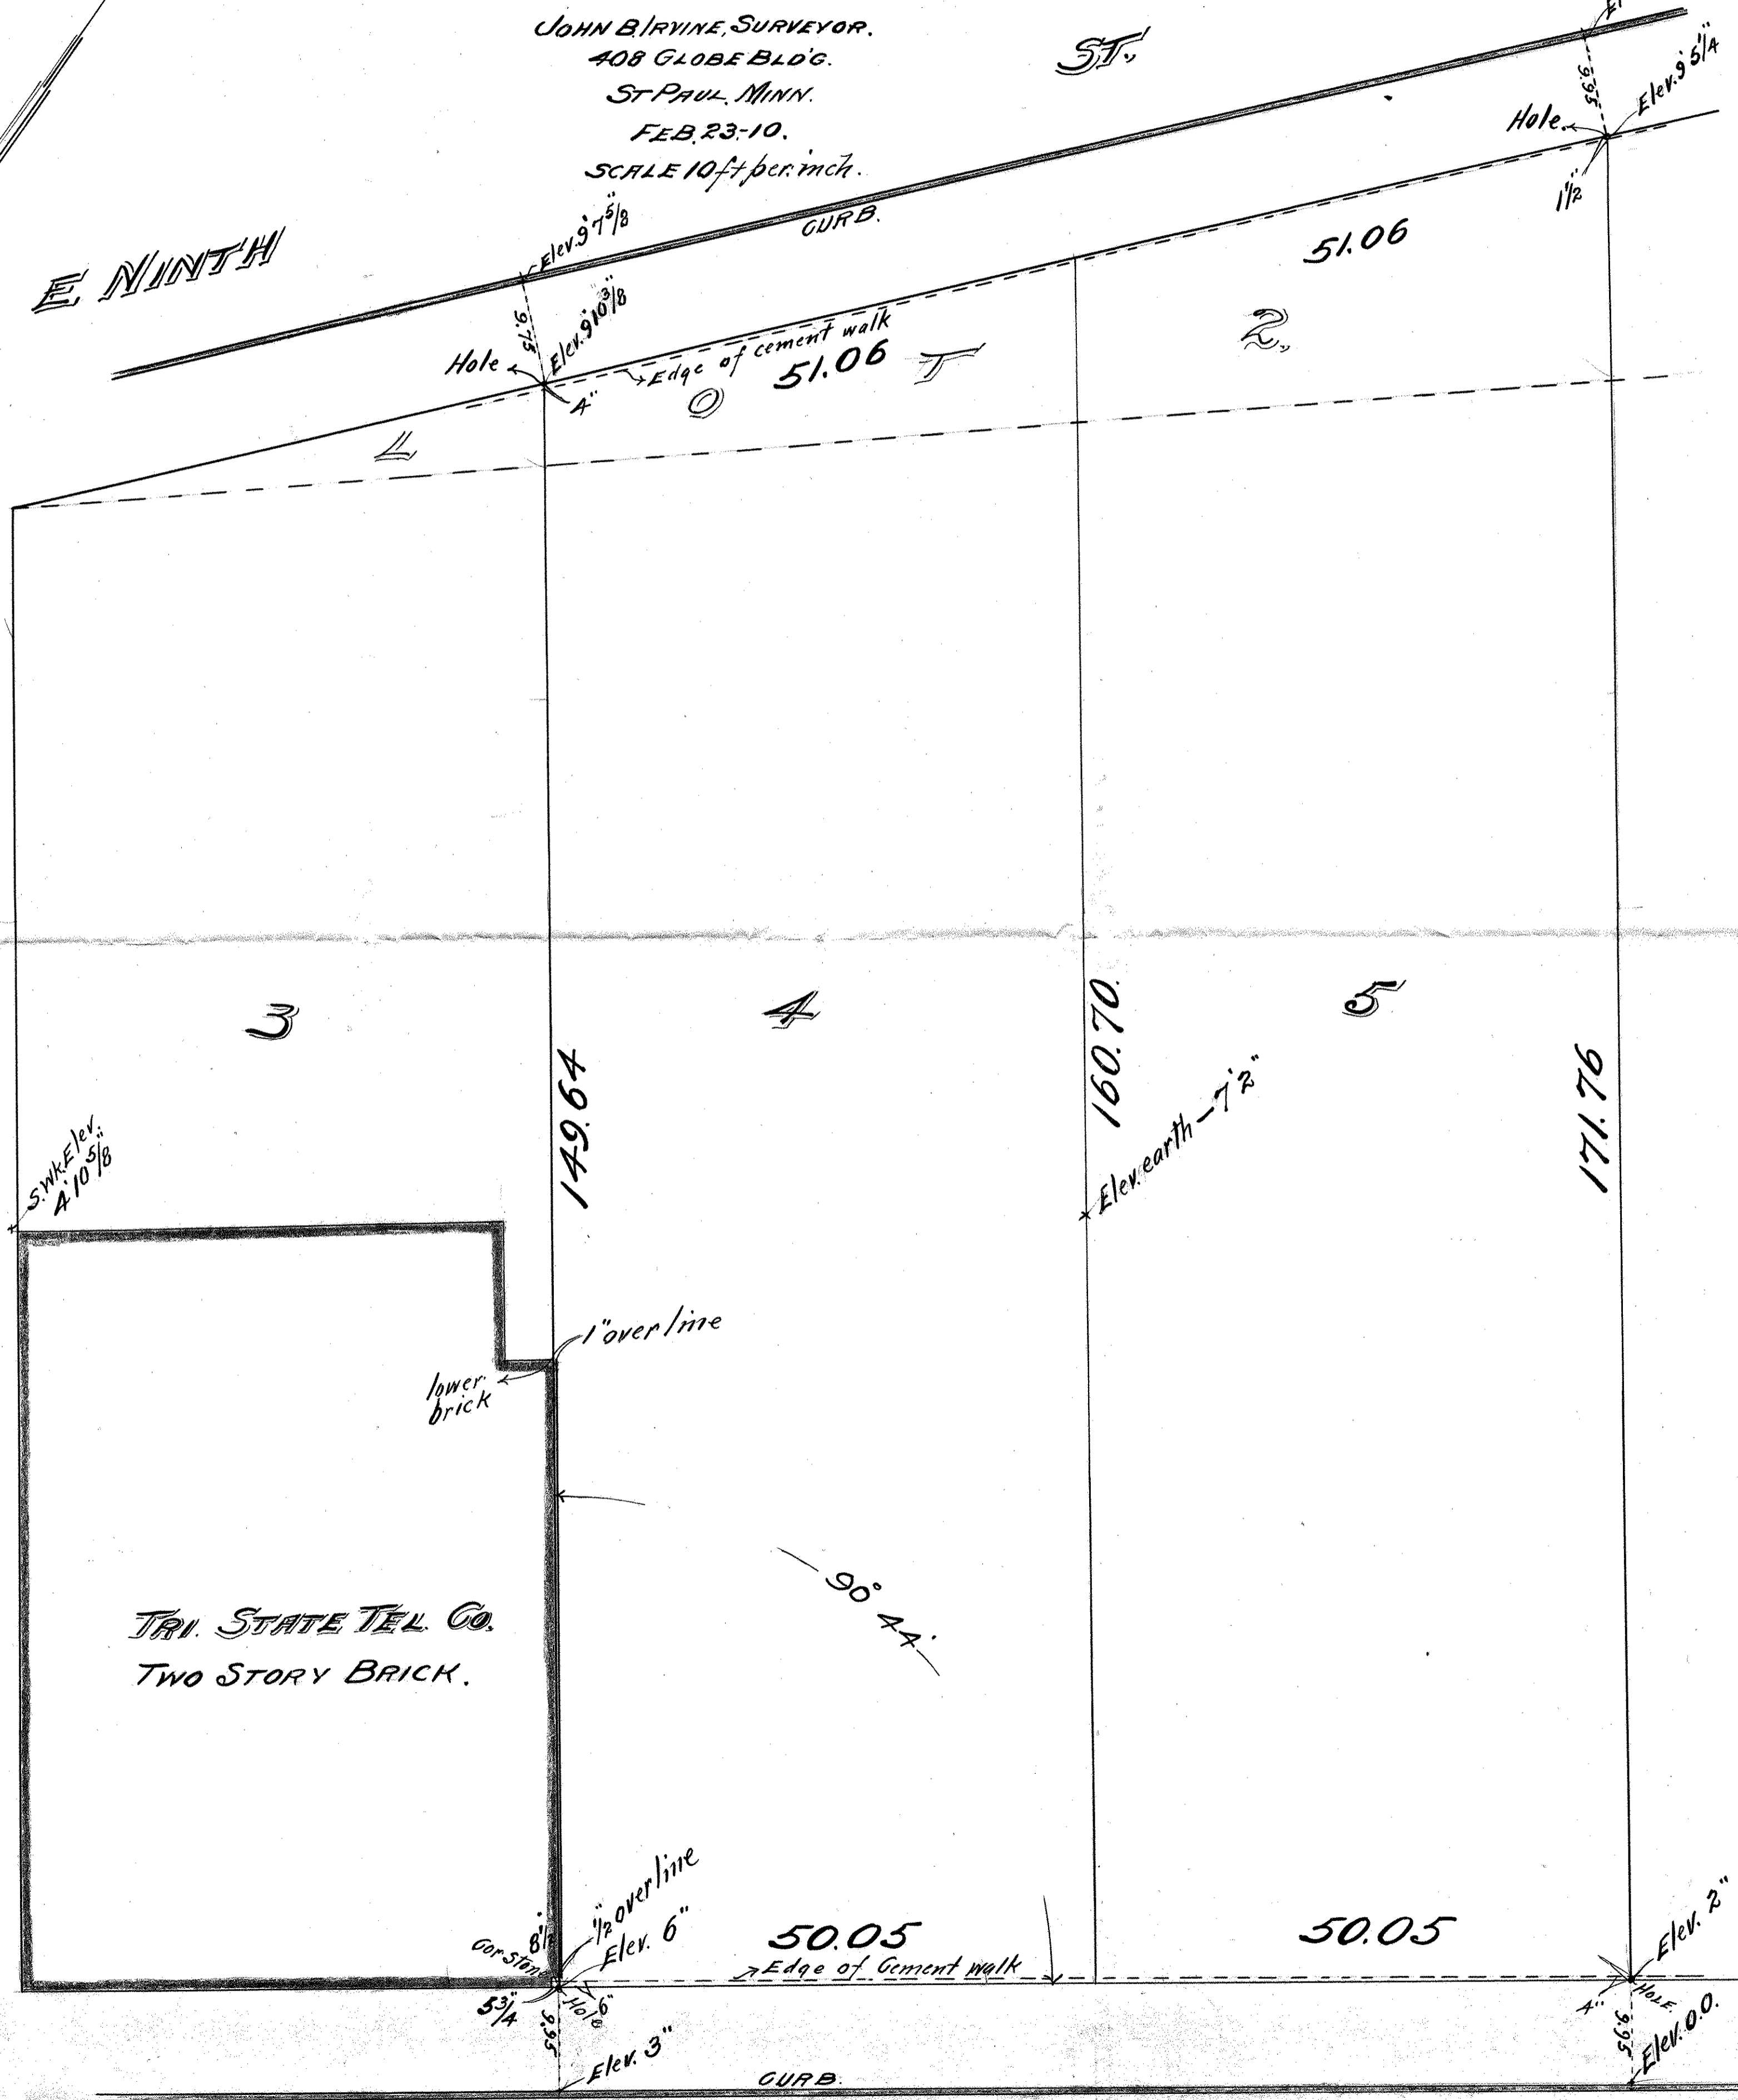

ST.

CEDAR

3

4

5

TRI. STATE TEL. CO.
 TWO STORY BRICK.

lower brick
 1" overline

90° 44'

 8 1/2"
 5 3/4"
 5 3/4"
 1/2" overline
 Elev. 6"
 Elev. 3"
 Hole

50.05
 Edge of Cement walk

CURB.

EIGHTH

ST.