

BLOCK 13
 BAZILLE & ROBERTS ADD.
 TO
 WEST ST. PAUL

JOHN B. IRVINE, SURVEYOR.

APRIL 27-1910.


SCALE 30 ft. per inch.

INDIANA

AIVE,

228.5

114.0

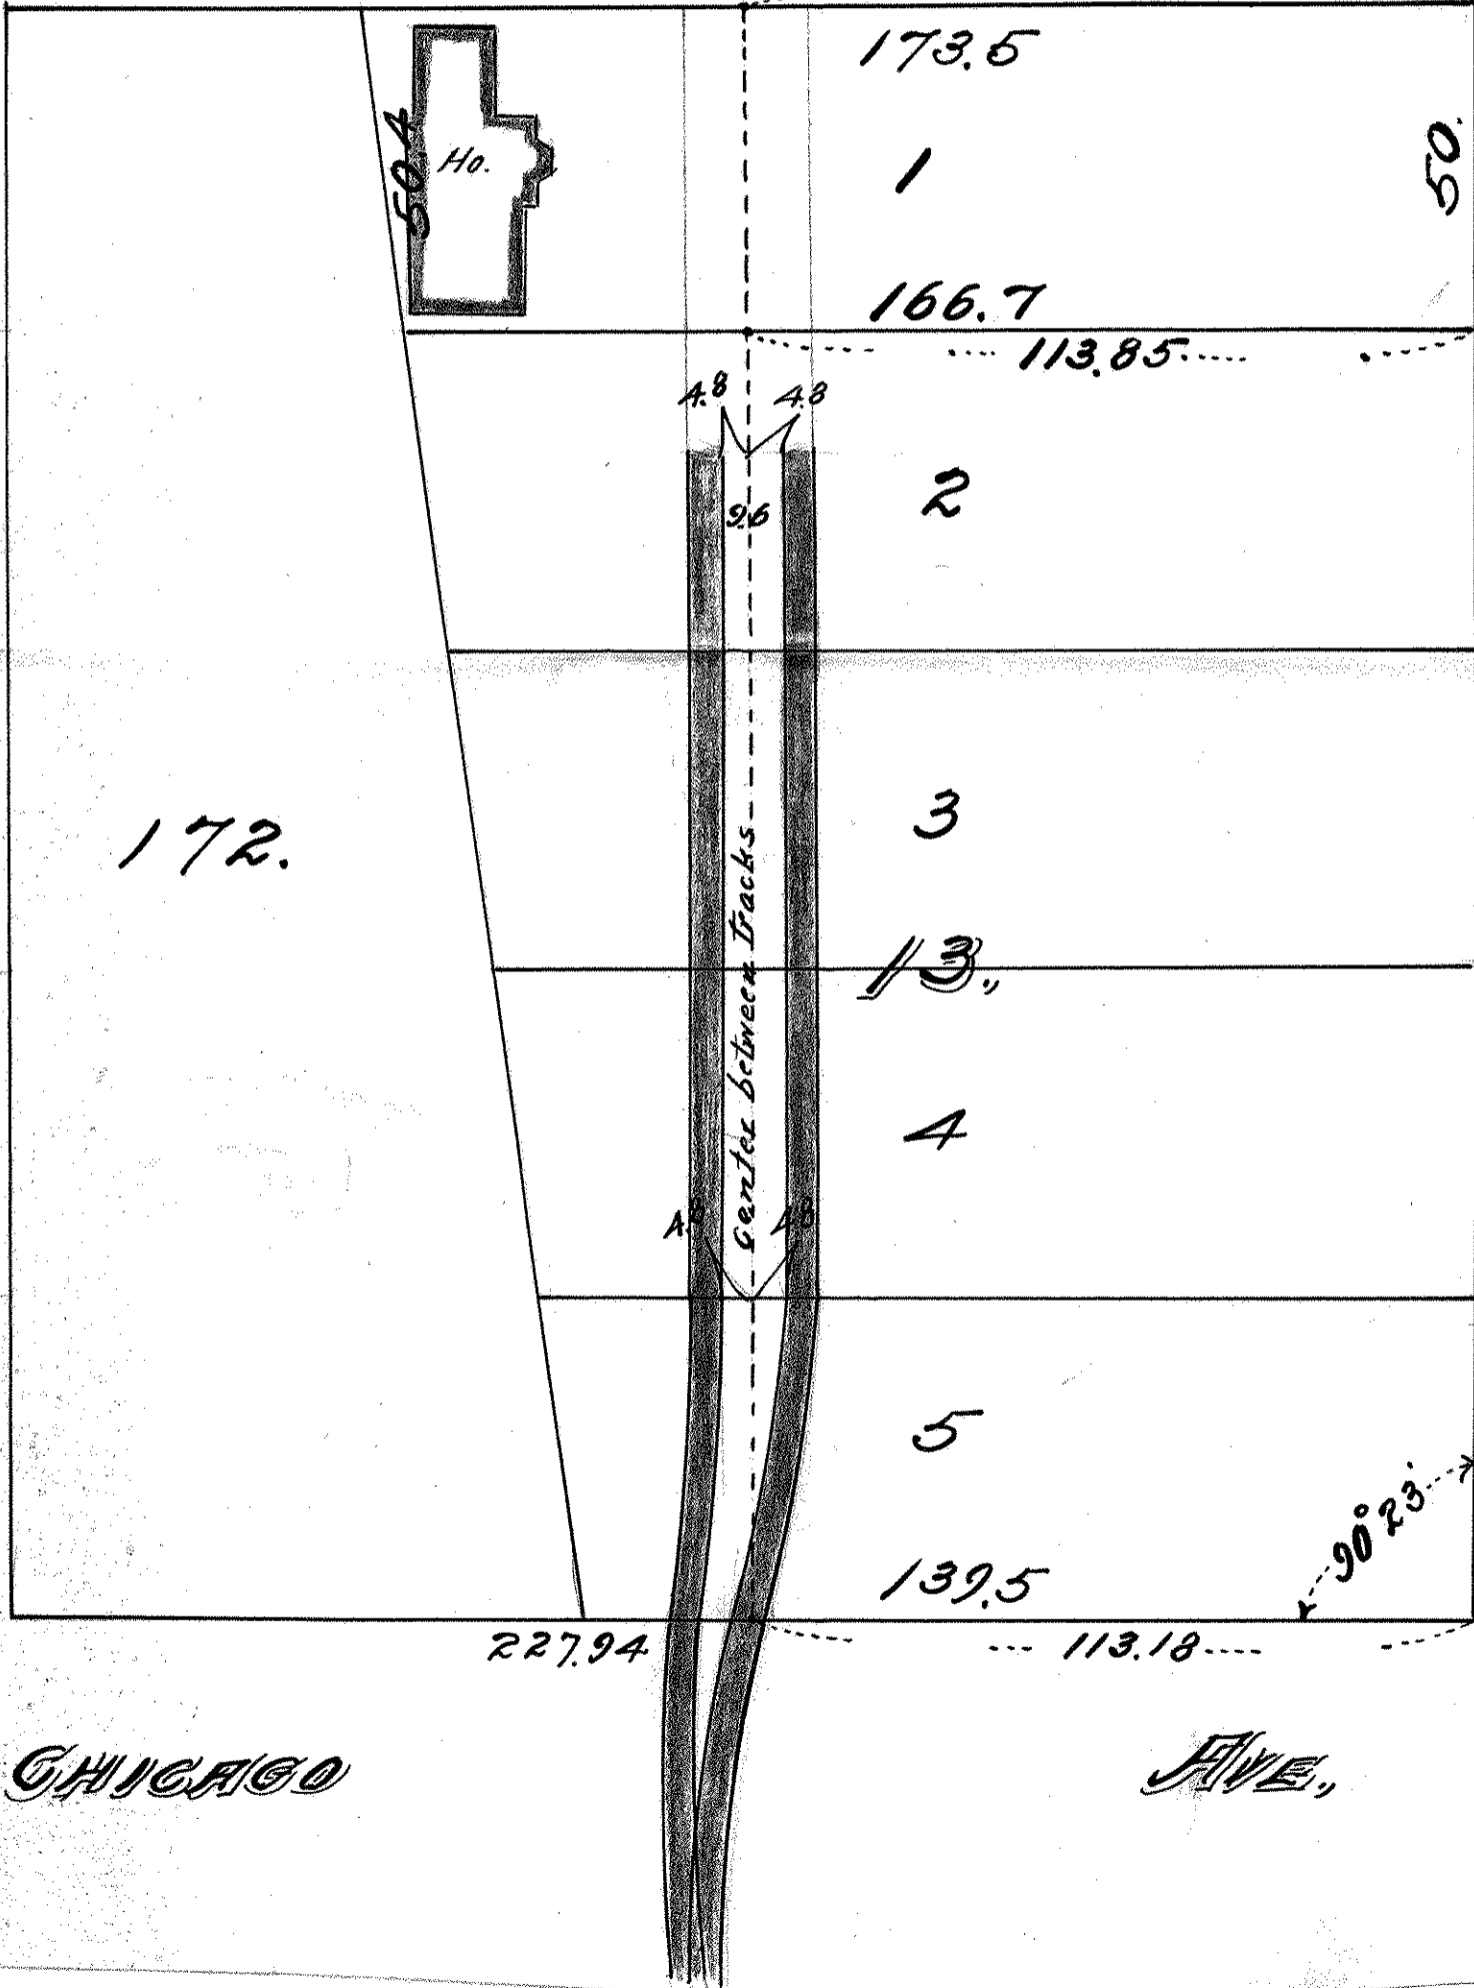

STARBUCK ST.

GUSTAF ST.

250.

250.

172.

13.

Center between Tracks

90° 23'

CHICAGO

AIVE,