


Vadnais Lake.

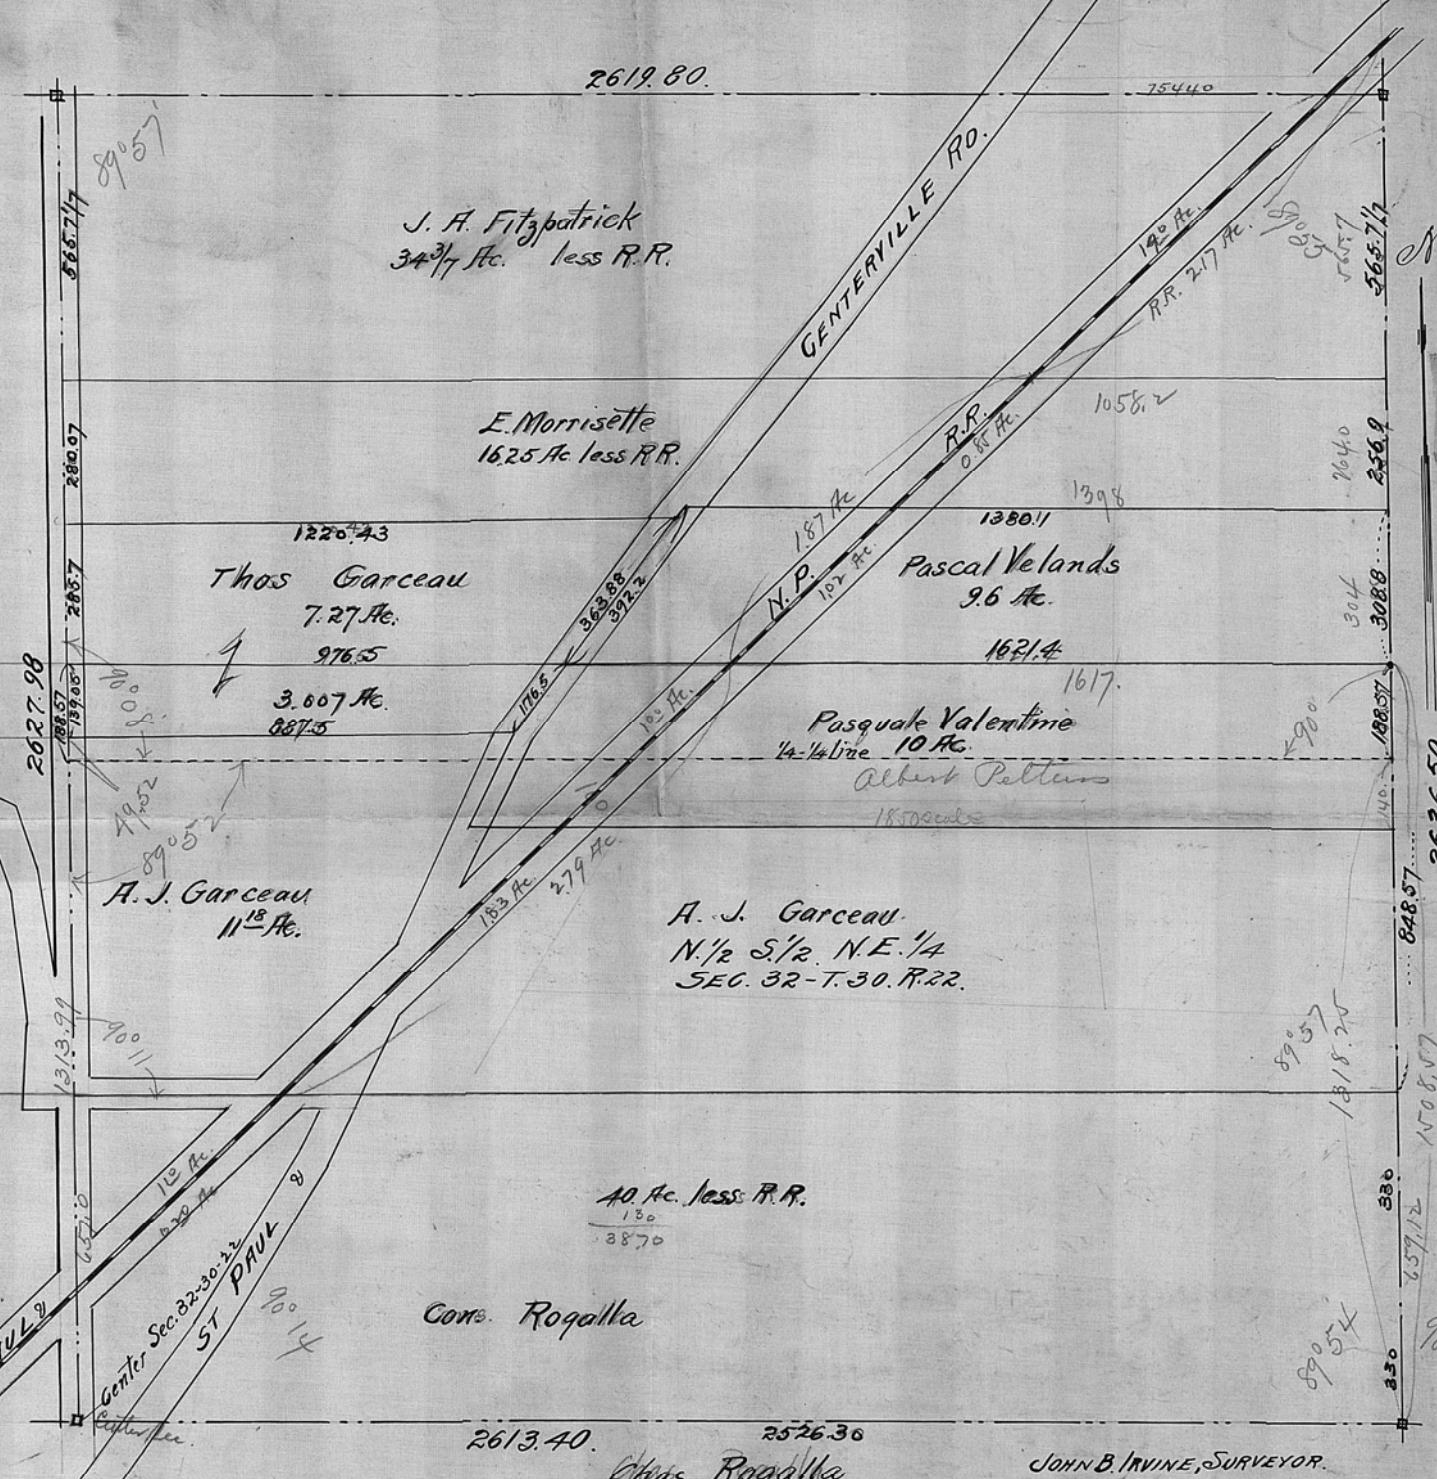

J. A. Fitzpatrick
34 ³/₄ Ac. less R.R.

E. Morrisette
16.25 Ac less R.R.

Thos Garceau
7.27 Ac.
976.5
3.607 Ac.
887.5

Pascal Velands
9.6 Ac.

Pasquale Valentine
1/4-1/4 line 10 Ac.

A. J. Garceau
11 ¹/₂ Ac.

A. J. Garceau
N. 1/2 S. 1/2 N.E. 1/4
SEC. 32-T. 30. R. 22.

40 Ac. less R.R.
130
387.0

Cons. Rogalla

2526.30
Chas Rogalla.

JOHN B. IRVINE, SURVEYOR.
408 GLOBE BLDG.
ST. PAUL, MINN.
AUG. 16-1911.
SCALE 200 ft. per inch.

Vadnais Lake

2619.80

J. A. Fitzpatrick
34 3/4 Ac. less R.R.

E. Morrisette
1625 Ac. less R.R.

Thos Garceau
7.27 Ac.

Pascal Velands
9.6 Ac.

3.607 Ac.

Pasquale Valentine
14-1/4 line 10 Ac

A. J. Garceau
11 1/2 Ac.

A. J. Garceau
N. 1/2 S. 1/2 N.E. 1/4
SEC. 32-T. 30. R. 22.

40 Ac. less R.R.

Conc. Rogalla

2613.40

2526.36

Chris Rogalla

JOHN B. IRVINE, SURVEYOR.
408 GLOBE BLDG.
ST. PAUL, MINN.
AUG. 16-1911.
SCALE 200 ft. per inch.

