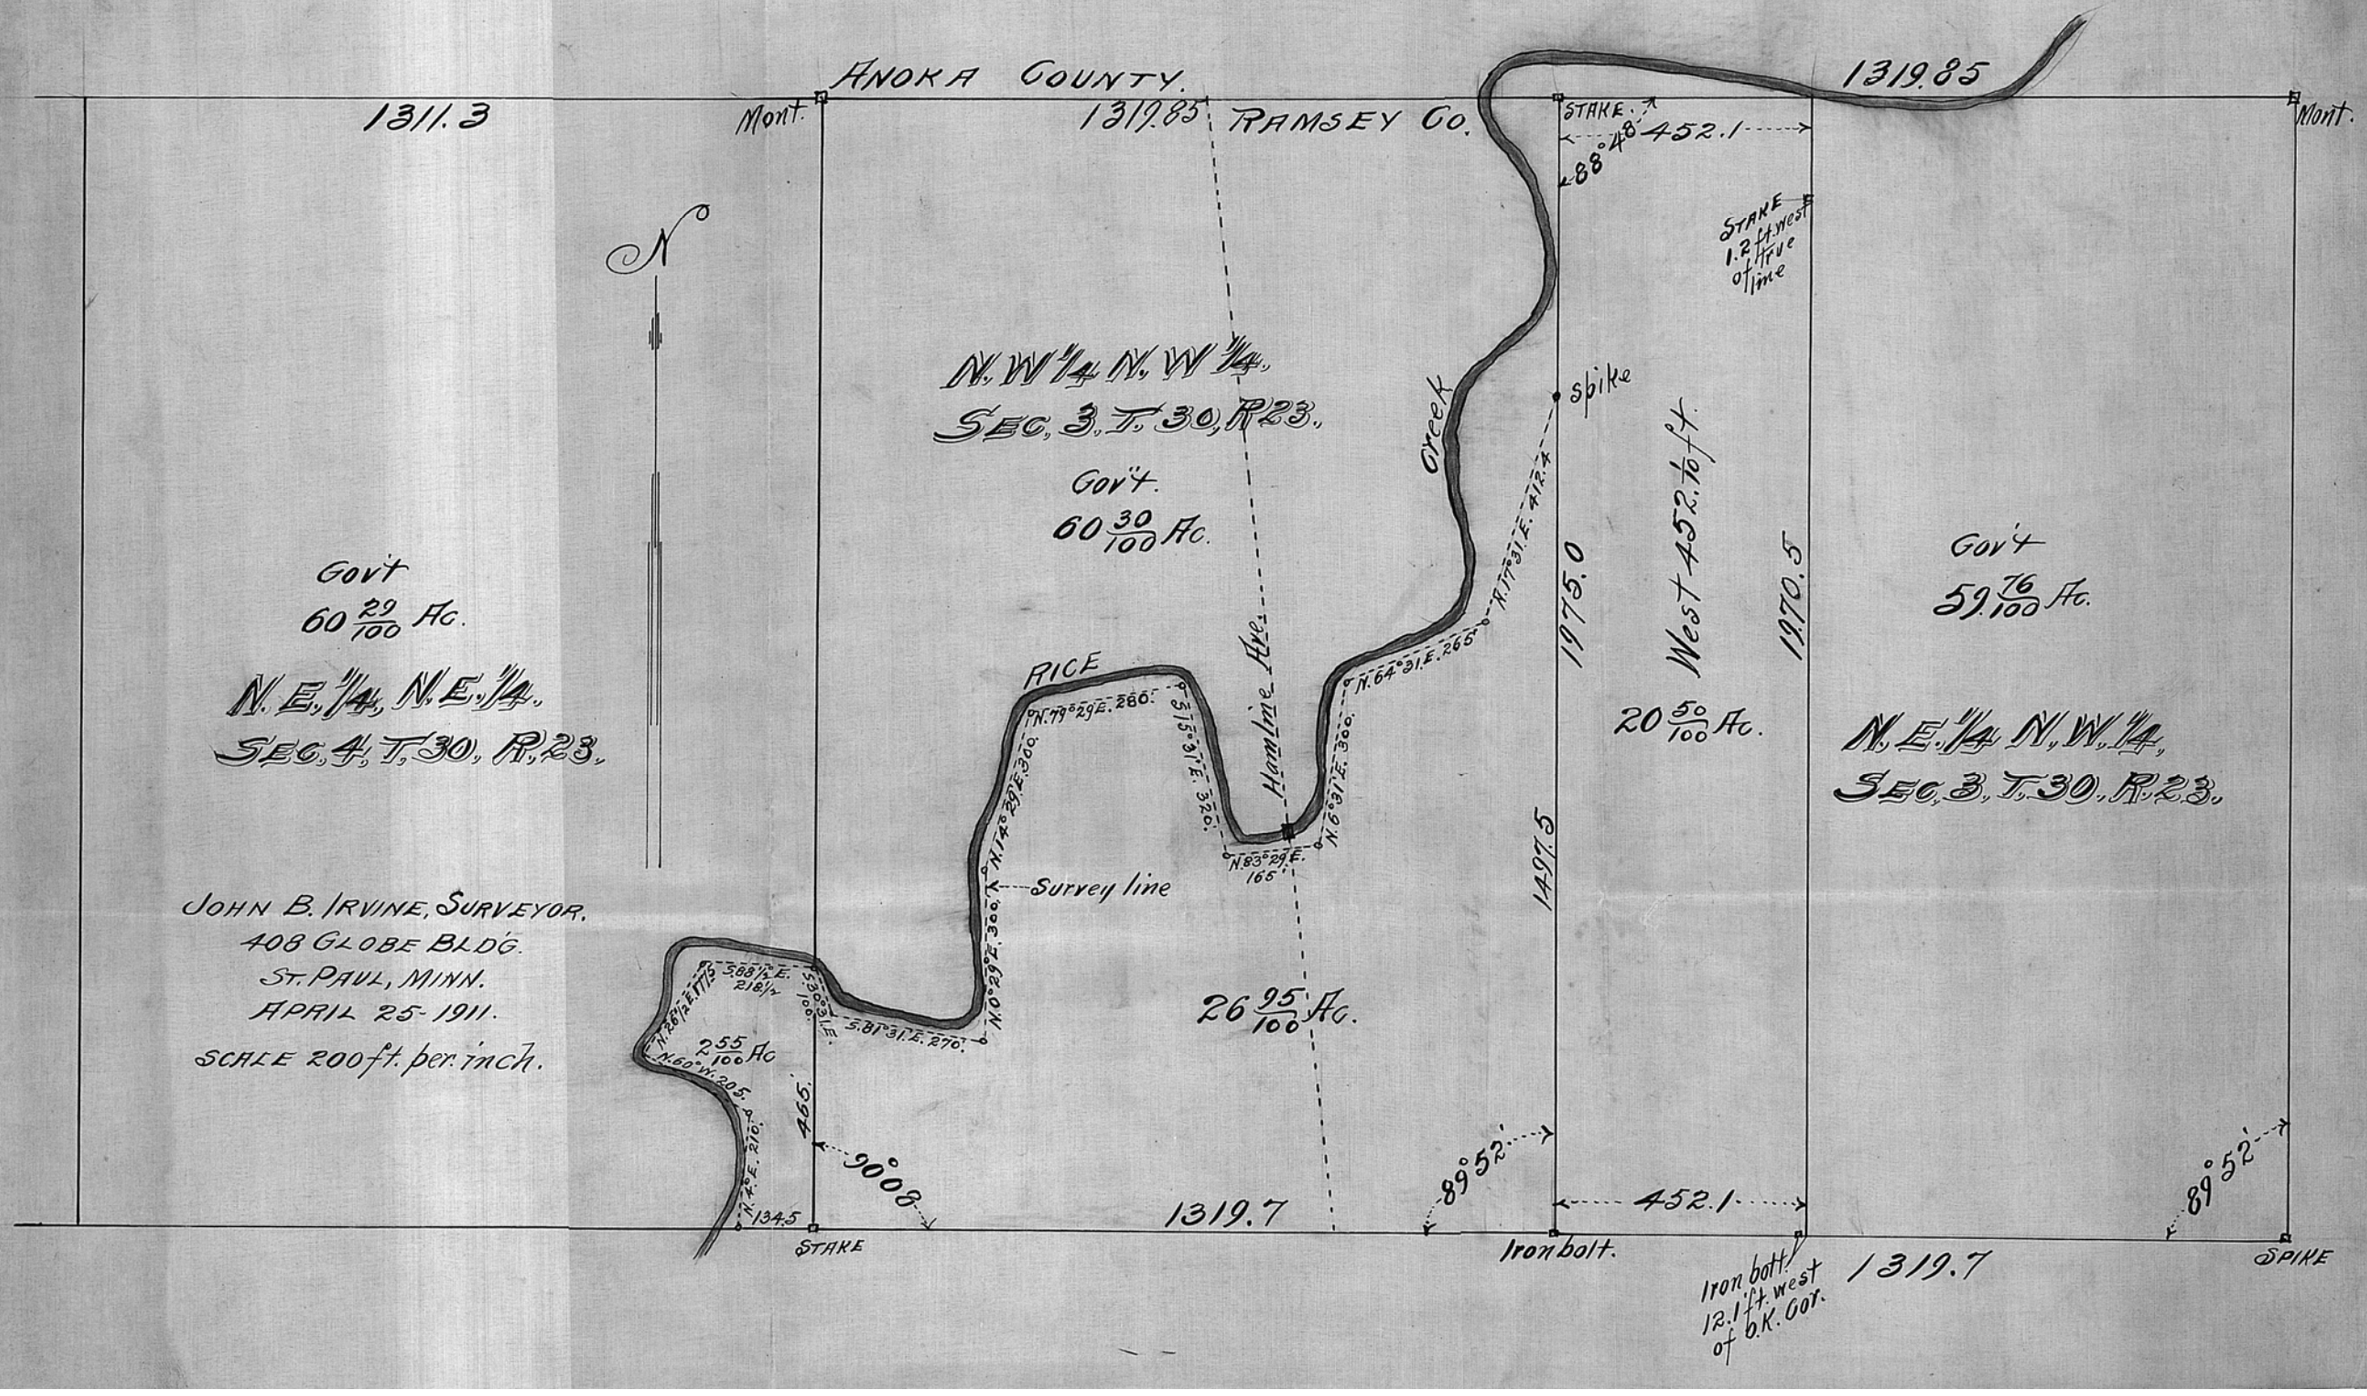
ANOKA COUNTY.
RAMSEY CO.
1311.3
1319.85
1319.85
Mont.
Mont.
STAKE
S 88° 48' 452.1
STAKE 1.2 ft. West of true line
N
N.W¼ N.W¼, SEC. 3, T. 30, R. 23.
Gov't 60 30/100 Ac.
Gov't 60 29/100 Ac.
N.E.¼ N.E.¼, SEC. 4, T. 30, R. 23.
Gov't 59 76/100 Ac.
N.E.¼ N.W.¼, SEC. 3, T. 30, R. 23.
Creek
spike
West 452.1 ft.
1975.0
1970.5
20 50/100 Ac.
RICE
N. 77° 29 E. 280.
N. 14° 29 E. 300.
N. 0° 29 E. 300.
S. 15° 31 E. 320.
N. 83° 29 E. 165.
N. 6° 31 E. 300.
N. 64° 31 E. 265.
N. 77° 31 E. 412.4
Survey line
S. 88½ E. 218½
S. 30° E. 100.
S. 81° 31 E. 270.
N. 26° E. 177.5
N. 60° W. 205.
N. 7° E. 270.
2.55/100 Ac.
26 95/100 Ac.
465.
90° 08
134.5
1319.7
89° 52'
452.1
89° 52'
1319.7
STAKE
Iron bolt.
Iron bolt 12.1 ft. west of S.K. Cor.
SPIKE
JOHN B. IRVINE, SURVEYOR.
408 GLOBE BLDG.
ST. PAUL, MINN.
APRIL 25- 1911.
SCALE 200 ft. per inch.