

LOTS 12 & 13

AUDITOR'S SUB'N.

No. 6.


JOHN B. IRVINE SURVEYOR.

408 GLOBE BLD'G.

ST. PAUL, MINN.

NOV. 3-1911.

UNIVERSITY AVE.

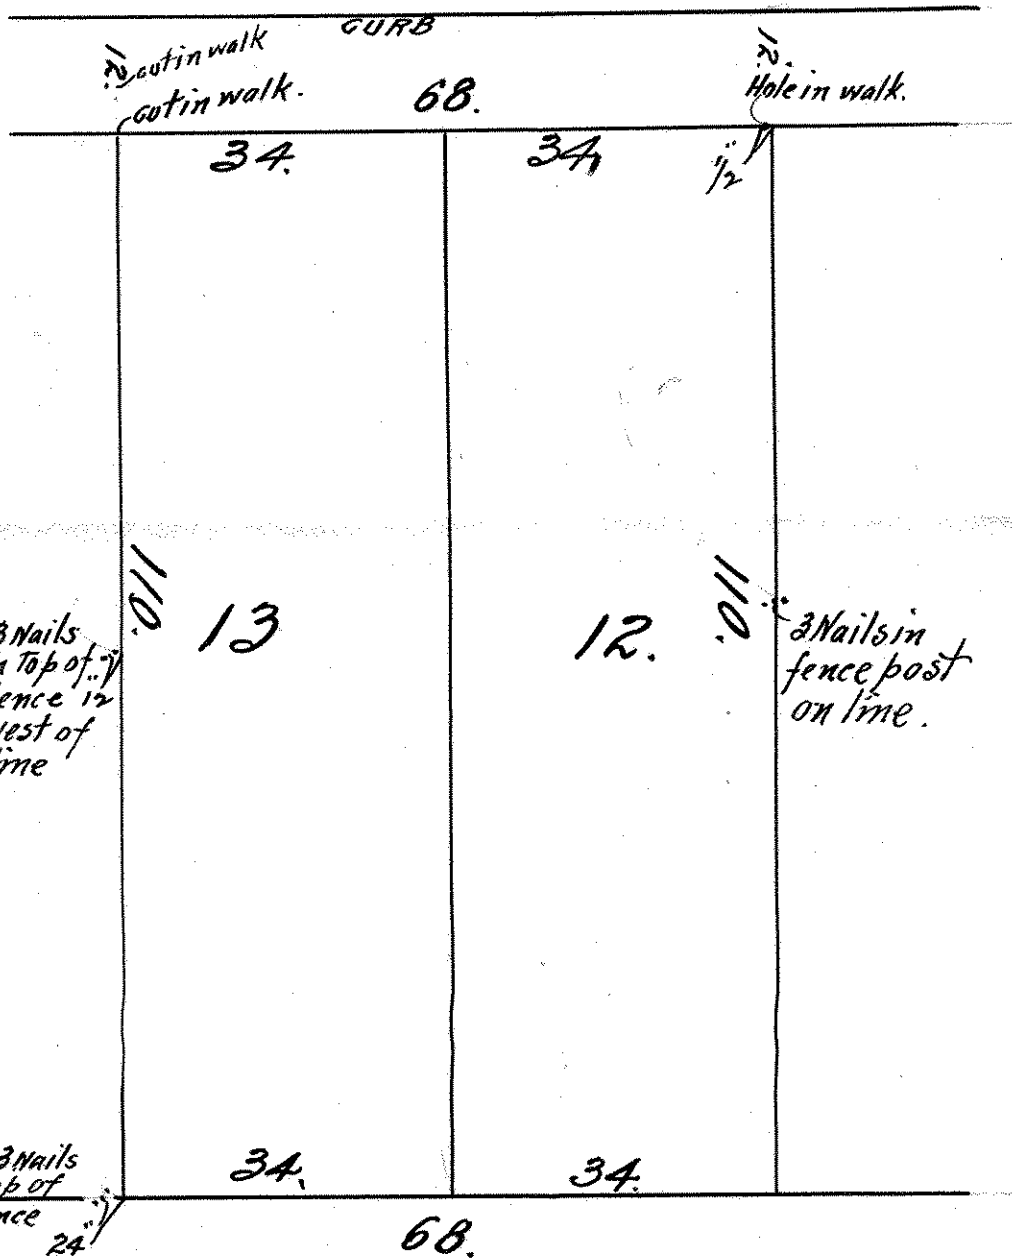

SCALE 20ft. per inch.